

15.145.20214.0000

STATE OF KANSAS
STATE CORPORATION COMMISSION


Form CP-4

WELL PLUGGING RECORD

Give All Information Completely
Make Required Affidavit
Mail or Deliver Report to:
Conservation Division
State Corporation Commission
P. O. Box 17027
Wichita, Kansas 67217
NORTH

Pawnee County, Sec. 20 Twp. 20 Rgc. (E) 19 (W)

Location as "NE/CNW/SW" or footage from lines SE NW SW
Lease Owner Clinton Oil Company
Lease Name Bartonek V Well No. 1
Office Address 217 N. Water, Wichita, Kansas 67202
Character of Well (completed as Oil, Gas or Dry Hole) oil
Date well completed 19
Application for plugging filed 19
Application for plugging approved 19
Plugging commenced March 13 19 72
Plugging completed March 20 19 72
Reason for abandonment of well or producing formation depleted

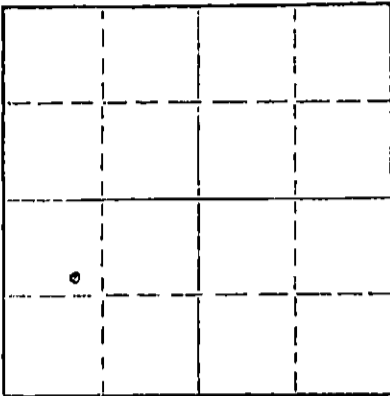

Locate well correctly on above Section Plat

If a producing well is abandoned, date of last production 19
Was permission obtained from the Conservation Division or its agents before plugging was commenced? yes

Name of Conservation Agent who supervised plugging of this well Leo Massey
Producing formation Depth to top Bottom Total Depth of Well 4325 Feet
Show depth and thickness of all water, oil and gas formations.

OIL, GAS OR WATER RECORDS

CASING RECORD

FORMATION	CONTENT	FROM	TO	SIZE	PUT IN	PULLED OUT
		0	451'	8 5/8"	451'	none
		0	4320'	5 1/2"	4320'	3130.27

Describe in detail the manner in which the well was plugged, indicating where the mud fluid was placed and the method or methods used in introducing it into the hole. If cement or other plugs were used, state the character of same and depth placed, from feet to feet for each plug set.

Set plug at 3900', sanded back to 3850' and dumped 5 sacks of cement.

Squeezed well with 3 sacks of hulls, 26 sacks of gel and 90 sacks of cement.

RECEIVED
STATE CORPORATION COMMISSION
MAR 22 1972
CONSERVATION DIVISION
Wichita, Kansas

Name of Plugging Contractor PIPE PULLERS, INC.
Address Box 486, Ellinwood, Kansas 67526

STATE OF KANSAS COUNTY OF BARTON, ss.
Evelyn Roth (employee of owner) or former operator of the above-described well, being first duly sworn on oath, says: That I have knowledge of the facts, statements, and matters herein contained and the log of the above-described well as filed and that the same are true and correct. So help me God.

(Signature) Evelyn Roth
Ellinwood, Kansas

Subscribed and sworn to before me this 21 day of March, 19 72

(Address)
Shader
Notary Public.

My commission expires July 7, 1972

DRILLERS LOG

Bartonek 1-V

CASING RECORD:

8 5/8" @ 451'
w/300 sx cement

5 1/2" @ 4327'
w/150 sx cement

TOTAL DEPTH: 4328'

COMPANY: Clinton Oil Company

CONTRACTOR: RED Tiger Drilling Co.

COMMENCED: May 25, 1971

COMPLETED: June 5, 1971

DESCRIPTION:

SE NW SW
20-20S-19W
Pawnee County,
Kansas

ELEVATION:

<u>FORMATION</u>	<u>FROM</u>	<u>TO</u>	<u>REMARKS</u>
Surface, Clay & Sand	0	280	
Shale	280	880	
Sand	880	930	
Shale	930	1180	
Shale & Red Bed	1180	1358	
Anhydrite	1358	1386	
Shale & Shells	1386	1935	
Shale & Lima	1935	3718	
Lime	3718	4170	
Lime & Sand	4170	4202	
Lime	4202	4270	
Lime & Chert	4270	4285	
Chert	4285	4328	


RECEIVED
STATE CORPORATION COMMISSION
MAR 5 1972
CONSERVATION DIVISION
Wichita, Kansas

I certify that this is a true and correct copy of the above log to the best of my knowledge.

RED TIGER DRILLING COMPANY

Jim Farrice
Jim Farrice

Subscribed and sworn to before me this 7th day of June, 1971.

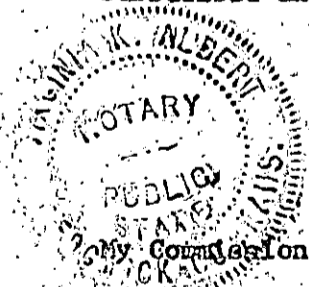

Virginia K. Albert
Notary Public

July 23, 1974