

STATE OF KANSAS  
STATE CORPORATION COMMISSION  
CONSERVATION DIVISION  
P. O. BOX 17027  
WICHITA, KANSAS 67217

WELL PLUGGING RECORD

McPherson County, Sec. 9 Twp. 20 Rge. 1 (E) (W)

Location as "NE/CNW/SW" or footage from lines NW SW SW

Lease Owner John Casebeer Oil & Gas

Lease Name Young #1 Well No.

Office Address McPherson, Kansas 67460

Character of Well (completed as Oil, Gas or Dry Hole)

Date well completed 19

Application for plugging filed 19

Application for plugging approved 19


Plugging commenced 8/1/75 19

Plugging completed 10/28/75 19

Reason for abandonment of well or producing formation depleted

If a producing well is abandoned, date of last production 19

Was permission obtained from the Conservation Division or its agents before plugging was commenced? yes

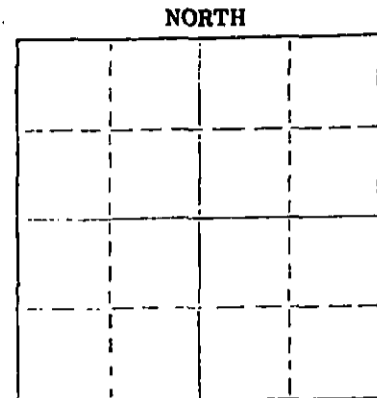

Locate well correctly on above Section Plat

Name of Conservation Agent who supervised plugging of this well Scott

Producing formation Depth to top Bottom Total Depth of Well 3448

Show depth and thickness of all water, oil and gas formations.

OIL, GAS OR WATER RECORDS

CASING RECORD

FORMATION	CONTENT	FROM	TO	SIZE	PUT IN	PULLED OUT
				8-5/8	161	none
				5 1/2"	3433	1092'

Describe in detail the manner in which the well was plugged, indicating where the mud fluid was placed and the method or methods used in introducing it into the hole. If cement or other plugs were used, state the character of same and depth placed, from feet to feet for each plug set.

Checked hole, ran sand to 2900' and dumped 5 sacks cement. Halliburton spotted oil, shot pipe at 1100' and pulled 35 joints. Bailed fluid to 190', set rock bridge to 180' and dumped 25 sacks cement. Mudded to 40', rock bridge to 30' and ran 10 sacks cement.

PLUGGING COMPLETE.

(If additional description is necessary, use BACK of this sheet)

Name of Plugging Contractor KELSO CASING PULLING

Address CHASE, KANSAS

STATE OF KANSAS COUNTY OF RICE

R. DARRELL KELSO (employee of owner) or (owner or operator) of the above-described

well, being first duly sworn on oath, says: That I have knowledge of the facts, statements, and matters herein contained and the log of the above-described well as filed and that the same are true and correct. So help me God.

(Signature) R. Darrell Kelso CHASE, KANSAS

(Address)

SUBSCRIBED AND SWORN TO before me this 30th day of October, 1975

My commission expires




Margaret Melcher Notary Public.

RECEIVED STATE CORPORATION COMMISSION

NOV 3 1975

CONSERVATION DIVISION Wichita, Kansas

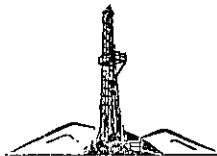

15.113.30012.0000

# Blackstone Drilling, Inc.

Box 455 • 523 West Kansas • Phone CH 1-1250

McPHERSON • KANSAS  
67460

October 19, 1965

COMPANY: JOHN CASEBEER  
 CONTRACTOR: BLACKSTONE DRILLING, INC.  
 FARM: J. L. YOUNG # 1  
 LOCATION: NW/4 SW/4 SW/4, Sec. 9-20-1W,  
 McPherson County, Kansas  
 COMMENCED: October 11, 1965  
 COMPLETED: October 18, 1965  
 ELEVATION:

0	to	30	Clay
30	to	95	Sand
95	to	156	Shale
156	to	445	Shale & Lime
445	to	740	Lime
740	to	1045	Lime & Shale
1045	to	1825	Shale & Lime
1825	to	1970	Lime
1970	to	2205	Lime & Shale
2205	to	2600	Lime
2600	to	2640	Shale & Lime
2640	to	2760	Lime
2760	to	2840	Lime & Shale
2840	to	2929	Shale & Lime
2929	to	2941	Conglomerate
2941	to	3155	Mississippi
3155	to	3207	Lime
3207	to	3355	Shale & Lime
3355	to	3410	Kinderhook
3410	to	3448	Viola
		3448	T. D.

RECEIVED  
 STATE CORPORATION COMMISSION  
 MAR 11 1965  
 CONSERVATION DIVISION  
 Wichita, Kansas

Cut 12 1/4 in. hole to 156 ft. and run 161 ft. of 8 5/8 in. surface pipe and cemented with 110 sacks cement and 3% Calcium Chloride. Plug down at 12:00 P.M., October 11, '65. Cut 7 7/8 in. hole to 3448 ft. and run 3451 ft. of 5 1/2 in. casing and set at 3433 ft. 15 ft. off bottom and cemented with 125 sacks pozmix. Plug down at 9:30 P.M., October 18, 1965.

TOPS: Lansing - 2317'      Mississippi - 2941'      Kinderhook - 3194'      Viola - 3410'  
 Simpson - 3441'

Measurements taken from K. B.

CERTIFICATE

I, H. J. Plouffe, President of Blackstone Drilling, Inc. do hereby certify that the above and foregoing is a true and correct copy of log on your J. L. YOUNG #1, located on the NW/4 SW/4 SW/4 of Sec. 9-20-1W, McPherson County, Kansas as reflected by the files of Blackstone Drilling, Inc.

H. J. Plouffe, President

Subscribed and sworn to before me a Notary Public in and for McPherson County, Kansas this 19th day of October, 1965.

Ruth McVay - Notary Public

My Commission Expires: December 18, 1965.