

STATE OF KANSAS
STATE CORPORATION COMMISSION


WELL PLUGGING RECORD

Give All Information Completely
Make Required Affidavit
Mail or Deliver Report to
Conservation Division
State Corporation Comm.
245 North Water
Wichita, KS 67202

McPherson County. Sec. 4 Twp. 20 Rge. 1w E/W
Location as "NE/CNW/SW" or footage from lines
C*SW-NW

Lease Owner Kermit Schmidt
Lease Name Koehn Well No. 1

Office Address R.R. #2 Box 4-A Canton Kans 67428
Character of Well (Completed as Oil, Gas or Dry Hole) Gas

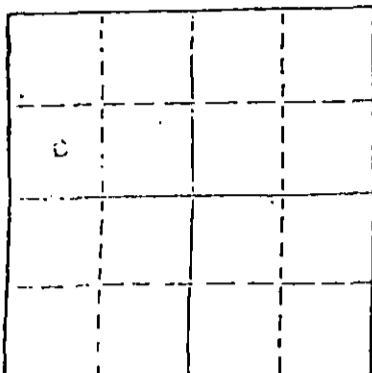

Locate well correctly on above
Section Plot

Date Well completed 7/27/ 19 77
Application for plugging filed 12/2/ 19 80
Application for plugging approved 12/5/ 19 80
Plugging commenced 12/6/ 19 80
Plugging completed 12/22 19 80

Reason for abandonment of well or producing formation Dry

If a producing well is abandoned, date of last production 8/ 19 80

Was permission obtained from the Conservation Division or its agents before plugging was commenced? Yes

Name of Conservation Agent who supervised plugging of this well Gilbert Toman
Producing formation Miss. Depth to top Bottom Total Depth of Well 3017
Show depth and thickness of all water, oil and gas formations.

OIL, GAS OR WATER RECORDS

CASING RECORD

FORMATION	CONTENT	FROM	TO	SIZE	PUT IN	PULLED OUT
	Surface	0	135	8 5/8		
		0	3011	4 1/2		1884

Describe in detail the manner in which the well was plugged, indicating where the mud fluid was placed and the method or methods used in introducing it into the hold. If cement or other plugs were used, state the character of same and depth placed, from feet to feet for each plug set.

Filled hole with sand to 3000 ft. and dumped 4 ex. cement

Set bridge at 150 ft. and filled to bottom of collar with 2 1/2 yards of readymix cement

(If additional description is necessary, use BACK of this sheet)

Name of Plugging Contractor

STATE OF COUNTY OF , ss.
(employee of owner) or (owner or operator)
of the above-described well, being first duly sworn on oath, says: That I have knowledge of the facts, statements, and matters herein contained and the log of the above-described well as filed and that the same are true and correct. So help me God.

(Signature)

SUBSCRIBED AND SWORN TO before me this day of (Address) , 19

Notary Public.

My commission expires

The original of this has been destroyed & sent to state
If you have a copy of this please return this to me for our records
Kermit



Blackstone Drilling, Inc.

Box 455 • 523 West Kansas • Phone (316) 241-1250
 1184 McPHERSON, KANSAS 67460

July 28, 1977

COMPANY: KERMIT SCHMIDT
 CONTRACTOR: BLACKSTONE DRILLING, INC.
 FARM: PETE KOEHN #1
 LOCATION: C SW/4 NW/4, Section 4-20-1W,
 McPherson County, Kansas
 COMMENCED: July 21, 1977
 COMPLETED: July 27, 1977
 ELEVATION: 1571 K. B.

0	to	55	Clay
55	to	90	Sand
90	to	135	Blue Shale
135	to	590	Shale & Lime
590	to	1450	Lime & Shale
1450	to	1965	Shale & Lime
1965	to	2085	Lime
2085	to	2400	Lime & Shale
2400	to	2951	Lime
2951	to	3017	Mississippi
		3017	T. D.

Cut 12 1/2" hole to 135' and run 136' of 8 5/8" surface pipe, cemented with 100 sacks of cement 135'. Plug down at 10:30 P. M., July 21, 1977. Cut 7 7/8" hole to 3017'. Run 3017' of 4 1/2" pipe, cemented at 3011', 6' off bottom with 75 sacks of cement. Plug down at 10:15 P. M., July 27, 1977.

TOPS: LANSING - 2343' MISSISSIPPI - 2951'

Measurements taken from KL B.

RECEIVED
 STATE CONSERVATION COMMISSION

DEC - 4 1980

CERTIFICATE

I, P. E. Plouffe, President of Blackstone Drilling, Inc. hereby certify that the above and foregoing is a true and correct copy of log on your well, Pete Koehn #1, located in the C SW/4 NW/4, Section 4-20-1W, McPherson County, Kansas as reflected by the files of Blackstone Drilling, Inc.

P. E. Plouffe
 P. E. Plouffe, President

Subscribed and sworn to before me a Notary Public in and for McPherson County, Kansas this 28th day of July, 1977.

Johnnie L. Schmidt
 Johnnie L. Schmidt - Notary Public

JOHNNIE L. SCHMIDT
 McPherson County, Kansas
 My Appt. Exp. June 23, 1981