


STATE OF KANSAS
STATE CORPORATION COMMISSION

Give All Information Completely
Make Required Affidavit
Mail or Deliver Report to:
Conservation Division
State Corporation Commission
211 No. Broadway
Wichita, Kansas

WELL PLUGGING RECORD

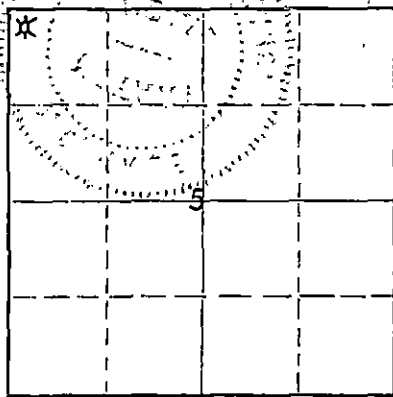

Locate well correctly on above
Section Plat

McPherson County, Sec. 5 Twp. 20s Rge. 1 (X) (W)
Location as "NE/CNW/SW" or footage from lines NW NW NW
Lease Owner Eagle Oil Company, Inc.
Lease Name Tinsley Well No. 1
Office Address 440 Oil Hill Road, Eldorado, Kansas 67042
Character of Well (completed as Oil, Gas or Dry Hole) Gas
Date well completed May 20 1965
Application for plugging filed December 4 1967
Application for plugging approved 19
Plugging commenced December 5 1967
Plugging completed December 7 1967
Reason for abandonment of well or producing formation Well is non-commercial, makes 60 MCF gas & 50 BSWPD & has standing valve at 2964
If a producing well is abandoned, date of last production February 15 1967
Was permission obtained from the Conservation Division or its agents before plugging was commenced? Yes

Name of Conservation Agent who supervised plugging of this well Hugh E. Scott
Producing formation Mississippian Dolomite Depth to top 2953 Bottom 2974 Total Depth of Well 3434 Feet
Show depth and thickness of all water, oil and gas formations.

OIL, GAS OR WATER RECORDS

CASING RECORD

FORMATION	CONTENT	FROM	TO	SIZE	PUT IN	PULLED OUT
Mississippian Dolomite	Gas & water	2953	2974	2 7/8 OD	3010	639

Describe in detail the manner in which the well was plugged, indicating where the mud fluid was placed and the method or methods used in introducing it into the hole. If cement or other plugs were used, state the character of same and depth placed, from _____ feet to _____ feet for each plug set.
Shot 2 7/8" casing at 1594
Shot 2 7/8" casing at 1199
Shot 2 7/8" casing at 639, pulled loose, mixed 2 sacks cement & poured down tubing & displaced
Pulled 2 7/8" casing, bridged hole at 220, dumped 25 sacks cement, filled up well into surface pipe
Bridged hole at 40', dumped 10 sacks cement, which filled hole to cellar
Covered cellar with dirt

RECEIVED
STATE CORPORATION COMMISSION
JAN 15 1968
CONSERVATION DIVISION
Wichita, Kansas

NOTE: This well originally drilled by Rex & Morris with 5 1/2" pipe set in 1963 and casing pulled in February 1963.

(If additional description is necessary, use BACK of this sheet)
Name of Plugging Contractor Eagle Oil Company, Inc.
Address 440 Oil Hill Road, Eldorado, Kansas 67042

STATE OF Kansas, COUNTY OF Sedgwick, ss.
Robert L. Carter (employee of owner) or (owner or operator) of the above-described well, being first duly sworn on oath, says: That I have knowledge of the facts, statements, and matters herein contained and the log of the above-described well as filed and that the same are true and correct. So help me God.

(Signature) Robert L. Carter
Robert L. Carter, 440 Oil Hill Road, Eldorado, Kansas 67042
(Address)

Subscribed and sworn to before me this 4th day of January, 1968.
G. C. Hale
Notary Public.
My commission expires March 18, 1968

