

WELL PLUGGING RECORD

Give All Information Completely  
Make Required Affidavit  
Mail or Deliver Report  
Conservation Division  
State Corporation Commission  
211 No. Broadway  
Wichita, Kansas

MC PHERSON County, Sec. 5 Twp. 20S Rge. 1W (E) X (W)

Location as "NE/CNW/SW" or footage from lines NW NW NW

Lease Owner REX & MORRIS DRILLING COMPANY AND T. A. WELLS

Lease Name TINSLEY Well No. 1

Office Address P. O. BOX 334, EL DORADO, KANSAS

Character of Well (completed as Oil, Gas or Dry Hole) DRY HOLE

Date well completed 7 FEBRUARY 19 63

Application for plugging filed 8 FEBRUARY 19 63

Application for plugging approved 11 FEBRUARY 19 63


Plugging commenced 11 FEBRUARY 19 63

Plugging completed 11 FEBRUARY 19 63

Reason for abandonment of well or producing formation DRY HOLE

If a producing well is abandoned, date of last production NONE 19

Was permission obtained from the Conservation Division or its agents before plugging was commenced? YES

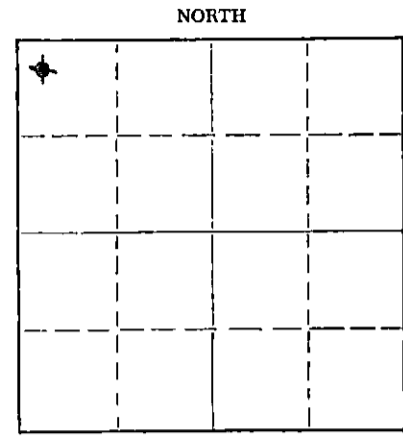

Locate well correctly on above Section Plat

Name of Conservation Agent who supervised plugging of this well CECIL JONES

Producing formation NONE Depth to top Bottom Total Depth of Well 3434 Feet

Show depth and thickness of all water, oil and gas formations.

OIL, GAS OR WATER RECORDS

CASING RECORD

FORMATION	CONTENT	FROM	TO	SIZE	PUT IN	PULLED OUT
SURFACE HOLE	WATER	SURFACE	218' RB	8 5/8" OD	212.08	LEFT IN
MISSISSIPPI LIME STONE	WATER & OIL	2957' RB	3165' RB	5 1/2" OD	3047'	2,163.67'
(SEE ATTACHED LOG)						

Describe in detail the manner in which the well was plugged, indicating where the mud fluid was placed and the method or methods used in introducing it into the hole. If cement or other plugs were used, state the character of same and depth placed, from feet to feet for each plug set.

5 1/2" CASING WAS CEMENTED AT 3,047' WITH 44 SACKS CEMENT IN PIPE. CASING FILLED WITH CRUSHED ROCK TO 2970' AND CEMENTED WITH 5 SACKS CEMENT. RIPPED & PULLED 5 1/2" CASING, FILLED HOLE WITH DRILLING MUD TO 218', SET 10' ROCK BRIDGE AND CEMENTED WITH 20 SACKS CEMENT, FILLED HOLE WITH DRILLING MUD TO 30' AND CEMENTED TO SURFACE WITH 10 SACKS CEMENT, WELDED STEEL CAP ON SURFACE PIPE.

RECEIVED  
STATE CORPORATION COMMISSION

MAR 8 1963

CONSERVATION DIVISION  
Wichita, Kansas

(If additional description is necessary, use BACK of this sheet)  
Name of Plugging Contractor REX & MORRIS DRILLING COMPANY  
Address P. O. BOX 334, EL DORADO, KANSAS

STATE OF KANSAS, COUNTY OF BUTLER, ss. A. H. FISHER (employee of owner) or (owner or operator) of the above-described well, being first duly sworn on oath, says: That I have knowledge of the facts, statements, and matters herein contained and the log of the above-described well as filed and that the same are true and correct. So help me God.

(Signature) A. H. Fisher

P. O. BOX 334, EL DORADO, KANSAS (Address)

SUBSCRIBED AND SWORN TO before me this 20TH day of FEBRUARY 19 63

My commission expires 8 AUGUST 1966

ELIZABETH DESCHNER Notary Public.

TINSLEY #1Rex & Morris Drilling Co. and T.A. Wells

Total Depth: 3434  
 Contractor: Rex & Morris  
 Commenced: 1-18-63  
 Completed: 2-14-63  
 Initial Prod.: D. & A.

Location: NW NW NW  
 Section 5-20S-1W  
 McPherson County, Kansas

Casing Record:  
 8 5/8 @ 218' w/150 sacks  
 5 1/2 @ 3047' w/100 sacks

FORMATION	DEPTH
Surface Hole	218
Lime and Shale	1040
Shale and Lime	1725
Lime and Shale	2115
Shale and Lime	2339
Lime (K.C.)	2615
Lime and Shale	2940
Conglomerate	2952
Lime (Miss.)	2995
Lime and Chat	3030
Lime	3165
Shale	3429
Dolomite Viola	3434
R.U.S.T. and C.O.	3010

RECEIVED  
 STATE CORPORATION COMMISSION

MAR 8 1963

CONSERVATION DIVISION  
 Wichita, Kansas

Ran Gamma Ray Neutron Log 3010.  
 Perf. log measure 2983-89, 6 per foot.  
 Show oil and gas  
 F.U. 31.23 B.F. (26.45 B.W. and 5.78 B.O.) 16 hrs.  
 Swab 7 hrs. Recovered 19.66 B.S.W. and 1.73 B.O.  
 Ripped and pulled 2163.8" 5 1/2. Plug and abandon.

I hereby certify the foregoing statements are true and correct to the best of my knowledge and belief.

Rex & Morris Drilling Company

By Paul D. Koontz  
 Paul D. Koontz, Geologist

STATE OF KANSAS  
 COUNTY OF BUTLER, SS.

Subscribed and sworn to before me, a Notary Public, this 19th day of February, 1963

Elizabeth Deschner  
 Elizabeth Deschner, Notary Public

My commission expires: August 8, 1966.