


WELL PLUGGING RECORD

Give All Information Completely  
Make Required Affidavit  
Mail or Deliver Report to:  
Conservation Division  
State Corporation Commission  
212 North Market, Insurance Bldg.  
Wichita, Kansas

McPherson County, Sec. 5 Twp. 20S Rge. 1 W (K) (W)

Location as "NE/CNW/SW" or footage from lines C/SW NE  
Lease Owner: Aladdin Petroleum Corporation  
Lease Name: Dielman Well No. 1  
Office Address: 809 Petroleum Building  
Character of Well (completed as Oil, Gas or Dry Hole) Dry Hole  
Date well completed November 3, 19 60  
Application for plugging filed November 3, 19 60  
Application for plugging approved November 3, 19 60  
Plugging commenced November 3, 19 60  
Plugging completed November 3, 19 60  
Reason for abandonment of well or producing formation Dry Hole

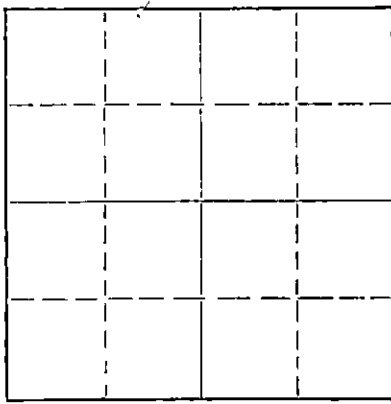

Locate well correctly on above Section Plat

If a producing well is abandoned, date of last production 19  
Was permission obtained from the Conservation Division or its agents before plugging was commenced? Yes

Name of Conservation Agent who supervised plugging of this well Cecil Jones  
Producing formation Depth to top Bottom Total Depth of Well 3585 Feet  
Show depth and thickness of all water, oil and gas formations.

OIL, GAS OR WATER RECORDS

CASING RECORD

FORMATION	CONTENT	FROM	TO	SIZE	PUT IN	PULLED OUT
Surface	water	0	209'	8 5/8	209'	none

Describe in detail the manner in which the well was plugged, indicating where the mud fluid was placed and the method or methods used in introducing it into the hole. If cement or other plugs were used, state the character of same and depth placed, from feet to feet for each plug set.

Heavy Mud to 180'  
#1 Plug 180' Howco Plug & 1/4 sx Hulls  
15 sx cement.  
Heavy mud to 35'  
#2 Plug 35' Howco Plug & 1/4 sx Hulls  
10 sx cement.  
Bridge Rat Hole 2 sx cement

RECEIVED  
STATE CORPORATION COMMISSION  
NOV 14 1960  
CONSERVATION DIVISION  
Wichita, Kansas

(If additional description is necessary, use BACK of this sheet)

Name of Plugging Contractor Shawver-Armour, Inc.  
Address 817 Central Building, Wichita, Kansas

STATE OF Kansas COUNTY OF Sedgwick ss.  
James M. Armour (employee of owner) or (owner or operator) of the above-described well, being first duly sworn on oath, says: That I have knowledge of the facts, statements, and matters herein contained and the log of the above-described well as filed and that the same are true and correct. So help me God.

(Signature) James M. Armour  
James M. Armour  
817 Central Building, Wichita, Kansas (Address)

SUBSCRIBED AND SWORN to before me this 3rd day of November, 19 60

My commission expires Dec. 29th, 1963 Marjorie Hall Notary Public.



