


STATE OF KANSAS
STATE CORPORATION COMMISSION

WELL PLUGGING RECORD

Give All Information Completely
Make Required Affidavit
Mail or Deliver Report to
Conservation Division
State Corporation Comm.
245 North Water
Wichita, KS 67202

McPherson County. Sec. 10 Twp. 20S Rge. 1W E/W
Location as "NE/CNW $\frac{1}{4}$ SW $\frac{1}{4}$ " or footage from lines
C SE/4
Lease Owner Bass Enterprises Production Company
Lease Name Hiabert Well No. 1
Office Address P.O. Box 2760 Midland, Texas 79701
Character of Well (Completed as Oil, Gas or Dry Hole)
Dry hole
Date Well completed June 27 1978
Application for plugging filed June 27 1978
Application for plugging approved June 27 1978
Plugging commenced June 27 1978
Plugging completed June 27 1978
Reason for abandonment of well or producing formation

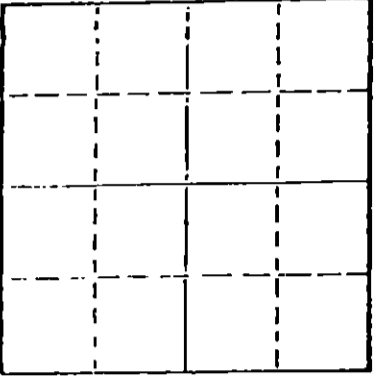

Locate well correctly on above Section Plat

If a producing well is abandoned, date of last production 19
Was permission obtained from the Conservation Division or its agents before plugging was commenced? yes

Name of Conservation Agent who supervised plugging of this well Toman
Producing formation Depth to top Bottom Total Depth of Well 3010'
Show depth and thickness of all water, oil and gas formations.

OIL, GAS OR WATER RECORDS

CASING RECORD

FORMATION	CONTENT	FROM	TO	SIZE	PUT IN	PULLED OUT
Surface		0	213	8 5/8"	201	0

Describe in detail the manner in which the well was plugged, indicating where the mud fluid was placed and the method or methods used in introducing it into the hold. If cement or other plugs were used, state the character of same and depth placed, from feet to feet for each plug set.

plug 25 sx @ 190'
plug 10 sx @ 40'
2 sx @ RH

RECEIVED
STATE CORPORATION COMMISSION
SEP 22 1978
CONSERVATION DIVISION
Wichita, Kansas


(If additional description is necessary, use BACK of this sheet)

Name of Plugging Contractor Brandt Drilling Co., Inc.

STATE OF Kansas COUNTY OF Sedgwick, ss.
Timothy E. Brandt (employee of owner) or (owner or operator)
of the above-described well, being first duly sworn on oath, says: That I have knowledge of the facts, statements, and matters herein contained and the log of the above-described well as filed and that the same are true and correct. So help me God.

(Signature) *Timothy E. Brandt*
1104 Douglas Bldg. Wichita, Ks.
(Address)

SUBSCRIBED AND SWORN TO before me this 30th day of June, 1978

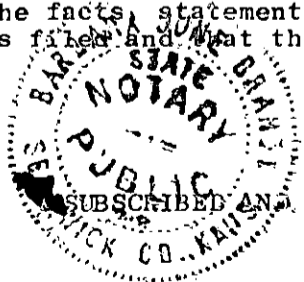

Barbara June Brandt
Barbara June Brandt Notary Public.

My commission expires February 29, 1980

DRILLER'S LOG

15.113.20545.0000

COMPANY: Bass Enterprises Production Co.

SEC: 10 T. 20S R. 1W

WELL NAME: Haibert No. 1

LOC: C SE/4

COUNTY: McPherson

RIG NO.

TOTAL DEPTH: 3010'

ELEVATION: 1543' Gr

COMMENCED: June 18, 1978

COMPLETED: June 28, 1978

1545' DF

1548' KB

CONTRACTOR: Brandt Drilling Co., Inc.

CASING RECORD:

SURFACE: 8 5/8" set @ 204' w/135 sks.

PRODUCTION: None

LOG

(Figures indicate bottom of Formations)

Surface soil & clay	27'
Sand	37'
Shale	387'
Lime	442'
Shale w/lime stks	615'
Lime & Sandy lime	749'
Shale & broken lime	1311'
Shale & sand	1757'
Lime, chalky	1902'
Shale	1932'
Lime, chalky & xln	2071'
Shale, black	2077'
Lime, dense	2102'
Sand & sandy shale	2162'
Sand, mica	2282'
Shale	2323'
Lime, xln & fossil	2708'
Lime, dense w/thin shale stks	2828'
Shale	2831'
Conglomerate	2915'
Lime & cherty lime	3010'
RTD	3010'

RECEIVED
STATE CORPORATION COMMISSION

SEP 22 1978

REGISTRATION DIVISION
WICHITA, KANSAS

STATE OF: TEXAS)

SS:

COUNTY OF: MIDLAND)

I, H. F. Wurtz, Jr. of Bass Enterprises Production Co.
upon oath state that the above and foregoing is a true and correct copy of
the log of the Haibert No. 1 well.

H. F. Wurtz, Jr.
Senior Production Clerk

Subscribed and sworn to before me this 19th day of September, 1978.

Appointment Expires Mar. 31, 1979

B. R. Scown
(Notary Public) B. R. Scown
Midland County, Texas