


Give All Information Completely  
Make Required Affidavit  
Mail or Deliver Report to:  
Conservation Division  
State Corporation Commission  
212 North Market Insurance Bldg.  
Wichita, Kansas

WELL PLUGGING RECORD

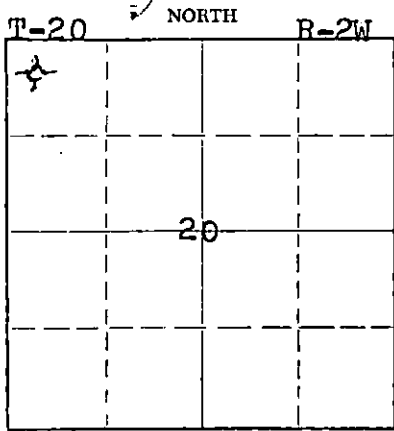

Locate well correctly on above Section Plat

McPherson County. Sec. 20 Twp. 20 Rge. (E) 2 (W)  
Location as "NE/CNW/SW" or footage from lines C NW NW NW  
Lease Owner Donald T. Ingling et al  
Lease Name Lumley A Well No. 1  
Office Address 623 1st Nat'l Bank Bldg., Wichita 2  
Character of Well (completed as Oil, Gas or Dry Hole) Dry Hole  
Date well completed March 1, 1960  
Application for plugging filed March 1, 1960  
Application for plugging approved March 1, 1960  
Plugging commenced March 1, 1960  
Plugging completed March 1, 1960  
Reason for abandonment of well or producing formation dry

If a producing well is abandoned, date of last production \_\_\_\_\_ 19\_\_\_\_  
Was permission obtained from the Conservation Division or its agents before plugging was commenced? Yes

Name of Conservation Agent who supervised plugging of this well Cecil M. Jones  
Producing formation \_\_\_\_\_ Depth to top \_\_\_\_\_ Bottom \_\_\_\_\_ Total Depth of Well 3559 Feet  
Show depth and thickness of all water, oil and gas formations.

OIL, GAS OR WATER RECORDS

CASING RECORD

FORMATION	CONTENT	FROM	TO	SIZE	PUT IN	PULLED OUT
				8 5/8"	160'	None

Describe in detail the manner in which the well was plugged, indicating where the mud fluid was placed and the method or methods used in introducing it into the hole. If cement or other plugs were used, state the character of same and depth placed, from \_\_\_\_\_ feet to \_\_\_\_\_ feet for each plug set.

Put bottom plug at 180 feet then 15 sacks cement. Filled hole to within 40 feet with mud and top plug at 40 feet then 8 sacks cement and 2 sacks cement in rathole

Well log attached

STATE CORPORATION COMMISSION

MAR 7 1960

CONSERVATION DIVISION  
Wichita, Kansas

(If additional description is necessary, use BACK of this sheet)  
Name of Plugging Contractor Donald T. Ingling  
Address 623 1st Nat'l Bank Bldg., Wichita 2

STATE OF KANSAS, COUNTY OF SEDGWICK, ss.  
D. T. Ingling (employee of owner) or (owner or operator) of the above-described well, being first duly sworn on oath, says: That I have knowledge of the facts, statements, and matters herein contained and the log of the above-described well as filed and that the same are true and correct. So help me God.

(Signature) [Signature]  
623 1st Nat'l Bank Bldg.  
(Address)

SUBSCRIBED AND SWORN TO before me this 1 day of March, 1960

My commission expires Feb. 27, 1964 [Signature] Notary Public.



WELL LOG - LUMLEY A-1

Donald T. Ingling, et al, Lease Owner

Section 20-20-2W

Donald T. Ingling, Contractor

Location: C NW NW NW

Commenced: 2-13-60

County: McPherson

Completed: 3-1-60

Production: Dry

Total Depth: 3559'

Elevation: 1491 RB

Casing: 160' 8 5/8" (80 sacks cement)

Figures below indicate bottom formation

40	surface clay	3115	lime
100	shale and sand	3158	lime
130	shale	3215	lime - Mississippi
160	shale and shells	3258	shale
420	shale and shells	3315	shale
535	shale and shells	3400	shale
655	shale and lime	3412	shale - Maquoketa
880	lime	3441	dolomite - Maquoketa
1035	lime	3450	lime - Viola
1430	shale	3465	lime
1485	shale and shells	3488	lime
1680	lime and shale	3500	sand - Simpson
1825	lime and shale	3507	sand and iron
1940	lime	3511	iron ore
2035	lime	3539	sand and shale
2110	lime	3550	shale and sand
2190	shale	3559	lime - Arbuckle
2290	sandy shale	3559	Total Depth
2341	shale		
2375	Lansing		
2470	lime		
2519	lime		
2610	lime		
2635	lime		
2708	lime		
2805	shale		
2915	shale		
3010	shale		
3027	shale		
3033	lime - Mississippi		
3036	Mississippi		
3098	Mississippi		

RECEIVED  
STATE CORPORATION COMMISSION  
MAR 7 1960  
CONSERVATION DIVISION  
Wichita, Kansas

I certify this is a true and correct copy of the above mentioned well.

STATE OF KANSAS )  
) ss.  
SEDGWICK COUNTY )

Donald T. Ingling

Subscribed and sworn to before me, a Notary Public, in said county and state.

ME Beach  
Notary Public

My commission expires: Feb. 27, 1964