


WELL PLUGGING RECORD

Give All Information Completely
Make Required Affidavit
Mail or Deliver Report to:
Conservation Division
State Corporation Commission
211 No. Broadway
Wichita, Kansas

NORTH

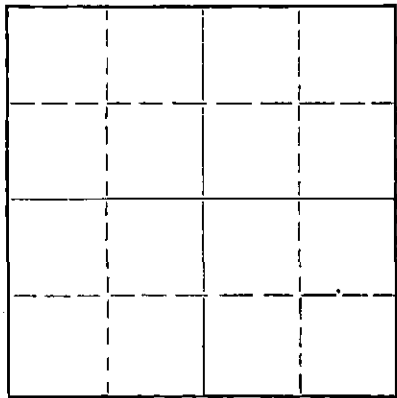

Locate well correctly on above
Section Plat

McPherson County, Sec. 24 Twp. 20 Rge. (E) 2 (W)
Location as "NE/CNW/SW" or footage from lines SW 1/4 SW 1/4 NE 1/4
Lease Owner Durbin Bond & Lewis Drilling Company
Lease Name Moddelmog Well No. 1
Office Address 915 Union Center, Wichita, Kansas
Character of Well (completed as Oil, Gas or Dry Hole) Dry Hole
Date well completed 12-31-1956
Application for plugging filed 12-31-1956
Application for plugging approved 12-31-1956
Plugging commenced 12-31-1956
Plugging completed 12-31-1956
Reason for abandonment of well or producing formation

If a producing well is abandoned, date of last production 19
Was permission obtained from the Conservation Division or its agents before plugging was commenced? Yes

Name of Conservation Agent who supervised plugging of this well Ruell Durkee
Producing formation Depth to top Bottom Total Depth of Well 3458 Feet
Show depth and thickness of all water, oil and gas formations.

OIL, GAS OR WATER RECORDS

CASING RECORD

FORMATION	CONTENT	FROM	TO	SIZE	PUT IN	PULLED OUT
				8 5/8"	158'	-0-

Describe in detail the manner in which the well was plugged, indicating where the mud fluid was placed and the method or methods used in introducing it into the hole. If cement or other plugs were used, state the character of same and depth placed, from feet to feet for each plug set.

Filled hole with heavy mud to 190'. Set bottom plug with 1/2 sack hulls, 15 sacks cement, through Drill Pipe. Filled with mud to 20'. Set top plug with 1 1/2 sack hulls and 5 sacks cement. Filled to base of cellar.

RECEIVED
STATE CORPORATION COMMISSION
JAN 4 1957
1-4-1957
CONSERVATION DIVISION
Wichita, Kansas

(If additional description is necessary, use BACK of this sheet)
Name of Plugging Contractor Lewis Drilling Company
Address 915 Union Center, Wichita, Kansas

STATE OF KANSAS, COUNTY OF SEDGWICK, ss.
J. Fred Hambricht (employee of owner, contractor or operator) of the above-described well, being first duly sworn on oath, says: That I have knowledge of the facts, statements, and matters herein contained and the log of the above-described well as filed and that the same are true and correct. So help me God.

(Signature) J. Fred Hambricht
915 Union Center, Wichita, Kansas (Address)

SUBSCRIBED AND SWORN TO before me this 31st day of December, 1956

My commission expires August 20, 1960
A. R. Derrington (A. R. Derrington) Notary Public.

PLUGGING
FILE SEC 24 T. 20 R. 2W
BOOK PAGE 131 LINE 6

WELL LOG

15.113.60347.0000

COMPANY Durbin Bond & Lewis Drilling Co.

SEC. 24 T. 20 R. 2W

FARM Modellmog

NO. 1


LOC. SW $\frac{1}{4}$ SW $\frac{1}{4}$ NE $\frac{1}{4}$

TOTAL DEPTH 3458
COMM. 12-16-56

COMP. 12-31-56

COUNTY McPherson
KANSAS

SHOT OR TREATED
CONTRACTOR Lewis Drilling Company

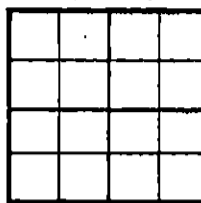

ISSUED

ELEVATION 1542 KB

PRODUCTION

CASING

20	10
15	8 5/8" - 158'
12	6
13	5

FIGURES INDICATE BOTTOM OF FORMATIONS

0 - 25	Surface soil
25 - 130	Sand
130 - 360	Shale
360 - 2005	Lime & shale
2005 - 2154	Shale & sand
2154 - 2240	Shale
2240 - 2900	Lime & shale
2900 - 2949	Lime, shale, and sand
2949 - 3095	Lime & shale
3095 - 3110	Chert
3110 - 3180	Lime
3180 - 3295	Shale
3295 - 3936	Lime & shale
3936 - 3440	Lime & sand
3440 - 3458	Shale & sand
3458	T. D.

Geologic Tops:

Lansing	2301
Mississippian	2940
Kinderhook	3201
Viola	3396
Simpson	3442

RECEIVED
STATE CORPORATION COMMISSION
JAN 4 X 1957
CONSERVATION DIVISION
Wichita, Kansas

State of KANSAS }
County of SEDGWICK } ss:

I, J. Fred Hambright of the Lewis Drilling Company

upon oath state that the above and foregoing is a true and correct copy of the log of the Modellmog #1 well.

PLUGGING
FILE SEC. 24 T. 20 R. 2W
BOOK PAGE 131 LINE 6

J. Fred Hambright
(J. Fred Hambright)

Subscribed and sworn to before me this 31st day of December 19 56

My Commission Expires: August 20, 1960

A. R. Derrington
NOTARY PUBLIC
(A. R. Derrington)