

STATE OF KANSAS
STATE CORPORATION COMMISSION

Form CP-4

Give All Information Completely
Make Required Affidavit
Mail or Deliver Report to:
Conservation Division
State Corporation Commission
212 No. Market
Wichita, Kansas 67202

WELL PLUGGING RECORD

McPherson

County. Sec. 22 Twp. 20 Rge. 2 W(E) (W)

Location as "NE/CNW&SW" or footage from lines 100' W of C NE/4 NE/4 SE/4

Lease Owner Barnett Oil Inc.

Lease Name Gaeddert Well No. 1

Office Address 1625 Vickers/KSB & T. Bldg., Wichita, Ks. 67202

Character of Well (completed as Oil, Gas or Dry Hole) Dry Hole

Date well completed June 13, 1978

Application for plugging filed 19

Application for plugging approved 19


Plugging commenced 19

Plugging completed June 13, 1978

Reason for abandonment of well or producing formation Dry Hole

If a producing well is abandoned, date of last production 19

Was permission obtained from the Conservation Division or its agents before plugging was commenced? Yes

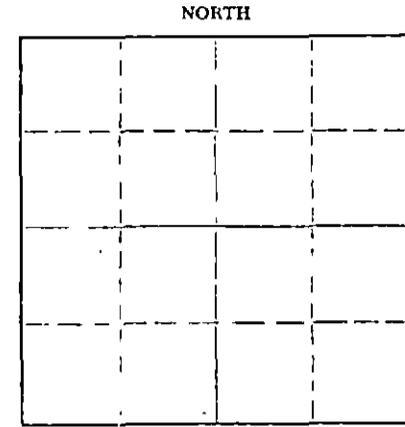

Locate well correctly on above Section Plat

Name of Conservation Agent who supervised plugging of this well Gilbert Toman, Holyrood, Kansas

Producing formation Depth to top Bottom Total Depth of Well Feet

Show depth and thickness of all water, oil and gas formations.

OIL, GAS OR WATER RECORDS

CASING RECORD

FORMATION	CONTENT	FROM	TO	SIZE	PUT IN	PULLED OUT
Clay		0	10'	8 5/8"	10'	None
Sand		10'	30'	8 5/8"	20'	None
Shale		30'	153'	8 5/8"	123'	None

Describe in detail the manner in which the well was plugged, indicating where the mud fluid was placed and the method or methods used in introducing it into the hole. If cement or other plugs were used, state the character of same and depth placed, from feet to feet for each plug set.

Set 1st Plug at 145' with 1 sack of hulls and 25 sacks of cement. Filled hole with mud to 40'. 2nd. plug set with 1 sack of Hulls & 25 sacks of cement, 2 sacks in rathole. Job completed at 9:45 P. M., June 13, 1978. Plugging completed by State Plugger, Gilbert Toman, Holyrood, Kansas.

RECEIVED
STATE CORPORATION COMMISSION
JUN 19 1978

CONSERVATION DIVISION
Wichita, Kansas

(If additional description is necessary, use BACK of this sheet)

Name of Plugging Contractor Blackstone Drilling, Inc.

Address Box 1184, McPherson, Kansas 67460

STATE OF Kansas, COUNTY OF Sedgwick, ss.

Barnett Oil Inc.

(employee of owner) or (owner or operator) of the above-described

well, being first duly sworn on oath, says: That I have knowledge of the facts, statements, and matters herein contained and the log of the above-described well as filed and that the same are true and correct. So help me God. BARNETT OIL INC.

(Signature) BY:

1625 Vickers/KSB & T Bldg., Wichita, Kansas 67202


(Address)

Subscribed and Sworn to before me this 16th day of June, 1978



Notary Public.

My commission expires

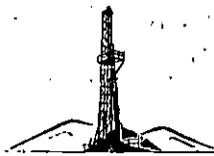

Blackstone Drilling, Inc.

Box 1184 • 523 West Kansas • Phone (316) 241-1250

McPHERSON, KANSAS 67460

June 14, 1978

COMPANY: BARNETT OIL INC.
 CONTRACTOR: BLACKSTONE DRILLING, INC.
 LOCATION: 100' W of C NE/4 NE/4 SE/4 22-20-2W,
 McPherson County, Kansas
 FARM: GAEDDERT #1
 COMMENCED: June 8, 1978
 COMPLETED: June 13, 1978
 ELEVATION: 1530'

0	to	10	Clay
10	to	30	Sand
30	to	153	Shale
153	to	675	Shale & Lime
675	to	1000	Lime & Shale
1000	to	1865	Shale & Lime
1865	to	2050	Lime & Shale
2050	to	2395	Shale & Lime
2395	to	3010	Lime
3010	to	3023	Mississippi
		3023	T. D.


Cut 12 $\frac{1}{4}$ " hole to 153' and run 155' of 8 $\frac{5}{8}$ " surface pipe, cemented with 150 sacks of cement at 153'. Plug down at 10:30 A. M., June 8, 1978. Cut 7 $\frac{7}{8}$ " hole to 3023'. Hole dry and abandoned. Set 1st plug at 145' with 1 sack of Hulls & 25 sacks of cement. Filled hole with mud to 40'. 2nd. plug set with 1 sack of Hulls & 10 sacks of cement, 2 sacks in rathole. Job completed at 9:45 P. M., June 13, 1978. Plugging completed by State Plugger, Gilbert Toman, Holyrood, Kansas.

TOPS: MISSISSIPPI - 2964'

Measurements taken from K. B.


CERTIFICATE

I, P. E. Plouffe, President of Blackstone Drilling, Inc. do hereby certify that the above and foregoing is a true and correct copy of log on your Gaeddert #1, located on the 100' W of C NE/4 NE/4 SE/4, Section 22-20-2W, McPherson County, Kansas as reflected by the files of Blackstone Drilling, Inc.

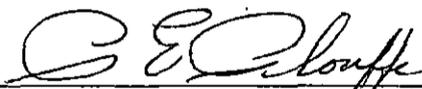
 P. E. Plouffe, President

Subscribed and sworn to before me a Notary Public in and for McPherson County, Kansas this 14th day of June, 1978.


 Johnnie L. Schmidt - Notary Public

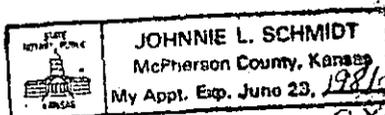

RECEIVED
 STATE CORPORATION COMMISSION
 JUN 19 1978
 CONSERVATION DIVISION
 Wichita, Kansas