


Give All Information Completely
Make Required Affidavit
Mail or Deliver Report to:
Conservation Division
State Corporation Commission
212 North Market, Insurance Bldg.
Wichita, Kansas

WELL PLUGGING RECORD

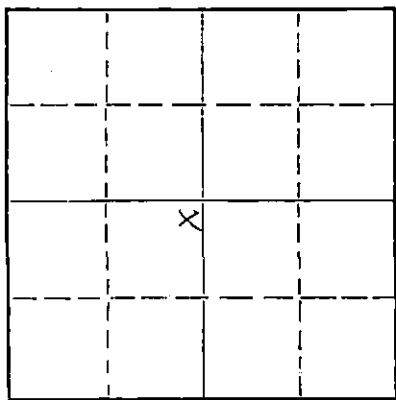

McPherson County, Sec. 2 Twp. 20 Rge. 2W (E) (W)
Location as "NE/CNW/SW" or footage from lines NE NE SW
Lease Owner Dr. G. E. Finkle
Lease Name Steinback "B" Well No. 1
Office Address 222 E. Kansas, McPherson, Kansas
Character of Well (completed as Oil, Gas or Dry Hole) oil
Date well completed 19
Application for plugging filed July 27, 1960 19
Application for plugging approved July 27, 1960 19
Plugging commenced 7-27-60 19
Plugging completed 8-2-60 19
Reason for abandonment of well or producing formation

If a producing well is abandoned, date of last production 19
Was permission obtained from the Conservation Division or its agents before plugging was commenced? yes

Name of Conservation Agent who supervised plugging of this well Cecil Jones
Producing formation Depth to top Bottom Total Depth of Well 2947 Feet
Show depth and thickness of all water, oil and gas formations.

OIL, GAS OR WATER RECORDS

CASING RECORD

FORMATION	CONTENT	FROM	TO	SIZE	PUT IN	PULLED OUT

Describe in detail the manner in which the well was plugged, indicating where the mud fluid was placed and the method or methods used in introducing it into the hole. If cement or other plugs were used, state the character of same and depth placed, from feet to feet for each plug set.

mixed and run 5 sacks cement
mixed and run 15 sacks jell and 7 sacks hulls
mudded hole to 180' set 10' rock bridge with 15 sacks cement
mud to 35' set rock bridge with 8 sacks cement

RECEIVED
STATE CORPORATION COMMISSION

AUG 4 1960

CONSERVATION DIVISION
Wichita, Kansas

8-4-1960

(If additional description is necessary, use BACK of this sheet)
Name of Plugging Contractor Southwest Casing Pulling Co., Inc.
Address Box 364, Great Bend, Kansas

STATE OF Kansas COUNTY OF Barton ss.
Southwest Casing Pulling Co., Inc. (employee of owner) or (owner or operator) of the above-described well, being first duly sworn on oath, says: That I have knowledge of the facts, statements, and matters herein contained and the log of the above-described well as filed and that the same are true and correct. So help me God.

(Signature) [Signature]
Box 364, Great Bend, Kansas
(Address)

SUBSCRIBED AND SWORN TO before me this 3 day of August, 1960

My commission expires December 18, 1962
[Signature] Notary Public.

COMPANY: Dr. G. E. Finkle
 CONTRACTOR: Mallard Drilling Company
 FARM: Steinbeck #1 (B)
 LOCATION: NE 1/4 SW Section 2-20-2W
 McPherson County, Kansas
 COMMENCED: August 12, 1957
 COMPLETED: August 20, 1957

0	to	60	Shale
60	to	80	Sand
80	to	166	Shale
166	to	380	Shale
380	to	605	Lime
605	to	715	Shale
715	to	1040	Lime
1040	to	1920	Lime and shale
1920	to	2035	Lime
2035	to	2249	Shale
2249	to	2300	Brown lime
2300	to	2435	Lime
2435	to	2620	Lime
2620	to	2775	Shale and lime
2775	to	2930	Shale and lime
2930	to	2947	Mississippi
		2947	T. D. Rotary

RECEIVED
 STATE CORPORATION COMMISSION
 AUG 21 1957
 COMPTROLLER OF REVENUE

Set 166 feet of 8 5/8" surface pipe. Cemented with 110 sacks cement.

Set 5 1/2 inch 2932 1/2. Cemented with 40 sacks cement.

TOPS: Chat 2930

Measurements taken from R.D.B. R.D.B. 5 1/2' from ground level.

C E R T I F I C A T E

I, C. C. Nelson, do hereby certify that the above and foregoing is a true and correct copy of log of the Steinbeck #1, McPherson County, Kansas, as reflected by files of the Mallard Drilling Company.

C. C. Nelson

Subscribed and sworn to before me a Notary Public, within and for Sedgwick County, Kansas, this 2nd day of September 1957.

Robert G. Hermal

My commission expires November 16, 1959