


WELL PLUGGING RECORD

Give All Information Completely
Make Required Affidavit
Mail or Deliver Report to:
Conservation Division
State Corporation Commission
211 No. Broadway
Wichita, Kansas

McPherson County, Sec. 11 Twp. 2D Rge. 2 (X) W (W)

Location as "NE/CNW/SW" or footage from lines C, SW NW NW
Lease Owner Dr. Guy E. Finkle et al
Lease Name H. A. Becker Well No. 1
Office Address 222 E. Kansas Ave., McPherson, Kansas
Character of Well (completed as Oil, Gas or Dry Hole) Dry hole
Date well completed February 18, 1957
Application for plugging filed February 17, 1957
Application for plugging approved February 17, 1957
Plugging commenced 1:30 PM February 18, 1957
Plugging completed 3:30 PM February 18, 1957
Reason for abandonment of well or producing formation Dry

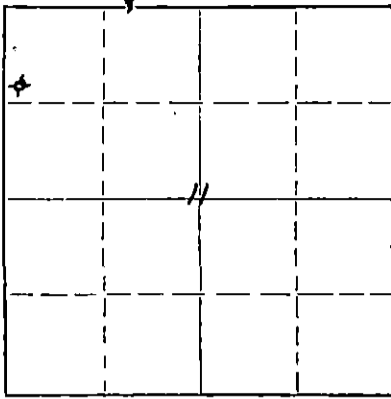

Locate well correctly on above Section Plat

If a producing well is abandoned, date of last production _____ 19____
Was permission obtained from the Conservation Division or its agents before plugging was commenced? Yes

Name of Conservation Agent who supervised plugging of this well Ruel Durkee, McPherson, Kansas
Producing formation _____ Depth to top _____ Bottom _____ Total Depth of Well 3005 Feet
Show depth and thickness of all water, oil and gas formations.

OIL, GAS OR WATER RECORDS

CASING RECORD

FORMATION	CONTENT	FROM	TO	SIZE	PUT IN	PULLED OUT
				8-5/8"	150'	None

Describe in detail the manner in which the well was plugged, indicating where the mud fluid was placed and the method or methods used in introducing it into the hole. If cement or other plugs were used, state the character of same and depth placed, from 150'-105' feet to 20'-5' feet for each plug set.

Gunned pits, circulated heavy mud on bottom, layed down one half of drill pipe and circulated heavy mud around. Layed down all but 5 joints of drill pipe. Ran measuring line and filled hole to 150' with heavy mud. Made bridge at 150' with tree limb, rock and 1/2 sack hulls and held weight of 5 joints drill pipe. Mixed 15 sacks cement and put through drill pipe on bridge. Layed down drill pipe and ran measuring line and filled hole with heavy mud to 20'. Put in plug and mixed 5 sacks cement and filled to bottom of cellar floor. Through plugging at 3:30 PM.

(If additional description is necessary, use BACK of this sheet)

Name of Plugging Contractor E. K. Carey Contractor
Address Box 620, McPherson, Kansas

STATE OF Kansas, COUNTY OF McPherson, ss.
Arland Bruce (employee of owner) or (owner or operator) of the above-described well, being first duly sworn on oath, says: That I have knowledge of the facts, statements, and matters herein contained and the log of the above-described well as filed and that the same are true and correct. So help me God.

(Signature) Arland Bruce
Box 620, McPherson, Kansas
(Address)

SUBSCRIBED AND SWORN to before me this 19th day of February, 1957

My commission expires November 13, 1960

Notary Public.

PLUGGING
FILE SEC 11 T 21 R 2W
BOOK PAGE 142 LINE 5

FEB 20 1957
2-20-1957
CONSERVATION DIVISION
Wichita, Kansas

ROTARY DRILLER'S LOG

Dr. Guy E. Finkle et al.
222 E. Kansas Ave.
McPherson, Kansas

Elevations: 1541 K.B.
1533 D.F.

H. A. Becker #1
C, N/2 NW/4
Sec. 11-20-2W
McPherson, County, Kansas

Casing Record:
8-5/8" @ 150' w/85 sks.
Pozmix cement

Well Commenced: 2-10-1957
Well Completed: 2-18-1957 D & A

Contractor: E. K. Carey Contractor, Rig #2, Box 620, McPherson, Kansas
Geologist: R. J. Gill, 5140 Valentine Road, Wichita, Kansas

Figures Indicate Bottom of Formation K. B.

base and cellar	7
sand	55
shale	85
shale and shells	120
lime and shale	355
anhydrite	410
lime and shale	455
lime	605
lime and shale	845
shale and lime	1645
lime and shale	1935
lime	2085
shale and sand	2175
shale and lime	2235
shale	2309
Kansas City lime	2640
lime and shale	2780
shale and lime	2953
Miss. chat	2971
lime	3005 TD

Geologist Tops:
Kansas City 2309
Mississippi 2953
Rotary Total Depth 3005

DST - 2953 to 2971' or 17' anchor.
Tool open 1 hr., very weak blow.
Closed 20 min. for BHP. Recovered
30' drilling mud, very few spots
oil. BHP 215#

This is to certify that the above information is to the best of my knowledge true and correct.

SUBSCRIBED AND SWORN to before me this 19th day of February, 1957.

E. K. CAREY CONTRACTOR

BY Herbert Rhoton
Herbert Rhoton, Superintendent

[Signature]
NP

My Commission Expires: November 13, 1960

PLUGGING
FILE SEC. 11 T. 20 R. 2W
BOOK PAGE 142 LINE 5

RECEIVED
STATE OF KANSAS COMMISSION
FEB 21 1957
CONSERVATION DIVISION
Wichita, Kansas