


STATE OF KANSAS
STATE CORPORATION COMMISSION

WELL PLUGGING RECORD

Give All Information Completely
Make Required Affidavit
Mail or Deliver Report to:
Conservation Division
State Corporation Commission
212 North Market, Insurance Bldg.
Wichita, Kansas

McPherson County, Sec. 11 Twp. 20 Rge. 2 ~~XXXXXX~~ (W)

Location as "NE/CNW/SW" or footage from lines CN/2 NE/4 SE/4
Lease Owner George R. Hess
Lease Name Becker Well No. 1
Office Address 505 N. Charles, McPherson, Kansas
Character of Well (completed as Oil, Gas or Dry Hole) Dry
Date well completed October 24, 1963 19
Application for plugging filed October 24, 1963 19
Application for plugging approved _____ 19
Plugging commenced October 24, 1963 19
Plugging completed October 25, 1963 19
Reason for abandonment of well or producing formation Dry

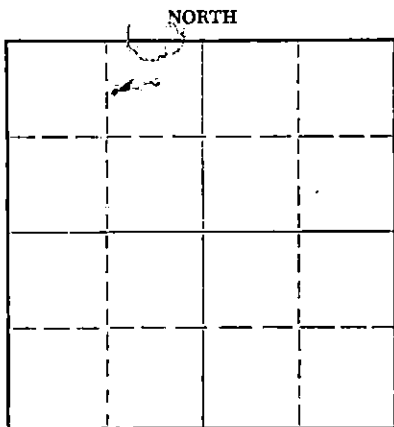

Locate well correctly on above
Section Plat

If a producing well is abandoned, date of last production _____ 19
Was permission obtained from the Conservation Division or its agents before plugging was commenced? Yes

Name of Conservation Agent who supervised plugging of this well Cecil Jones, McPherson, Kansas
Producing formation _____ Depth to top _____ Bottom _____ Total Depth of Well _____ Feet
Show depth and thickness of all water, oil and gas formations.

OIL, GAS OR WATER RECORDS

CASING RECORD

FORMATION	CONTENT	FROM	TO	SIZE	PUT IN	PULLED OUT
Clay		0	10			
Sand		10	40			
Shale		40	150	8 5/8	150	None

Describe in detail the manner in which the well was plugged, indicating where the mud fluid was placed and the method or methods used in introducing it into the hole. If cement or other plugs were used, state the character of same and depth placed, from _____ feet to _____ feet for each plug set.

Bottom Plug set at 150 ft. with rock bridge of 20
sacks cement. Top plug set at 30 ft. with 8 sacks
2 sacks in rathole. Hole plugging completed at 11:00 A.M.
October 25, 1963 by State Plugger, Cecil Jones, McPherson,
Kansas.

RECEIVED
STATE CORPORATION COMMISSION

OCT 30 1963

CONSERVATION DIVISION
Wichita, Kansas

(If additional description is necessary, use BACK of this sheet)
Name of Plugging Contractor Blackstone Drilling, Inc.
Address Box # 455, McPherson, Kansas

STATE OF Kansas COUNTY OF McPherson, ss.
George R. Hess (employer or owner or operator) of the above-described well, being first duly sworn on oath, says: That I have knowledge of the facts, statements, and matters herein contained and the log of the above-described well as filed and that the same are true and correct. So help me God.


(Signature) George R. Hess
505 N. Charles, McPherson, Ks.
(Address)

SUBSCRIBED AND SWORN TO before me this 29 day of October, 19 63

My commission expires January 17, 1965
Carroll D. Winslow Notary Public.

INVOICED

DATE 10/30/63
INV. NO. 7993-W

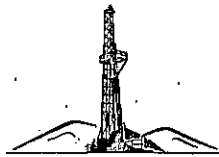

Blackstone Drilling, Inc.

P. O. BOX 455 • PHONE CH 1-1250

McPHERSON • KANSAS

October 25, 1963

COMPANY: GEORGE R. HESS
 CONTRACTOR: BLACKSTONE DRILLING, INC.
 FARM: DECKER #1
 LOCATION: CN/2 NE/4 SE/4, Sec. 11-20-2
 McPherson County, Kansas
 COMMENCED: October 19, 1963
 COMPLETED: October 25, 1963
 ELEVATION: 1545 K.B.

0	to	10	Clay
10	to	40	Sand
40	to	360	Shale
360	to	845	Lime
845	to	1105	Lime & Shale
1105	to	1700	Shale & Lime
1700	to	2020	Lime & Shale
2020	to	2295	Shale & Lime
2295	to	2317	Shale
2317	to	2645	Lime
2645	to	2770	Lime & Shale
2770	to	2875	Lime
2875	to	2935	Lime & Shale
2935	to	2993	Mississippi
		2993	T. D.

RECEIVED
 STATE CORPORATION COMMISSION

NOV 4 1963

CONSERVATION DIVISION
 Wichita, Kansas

2 5/8 in.

Cut 12 1/4 in. hole to 150 ft. and run 152 ft. of surface pipe and cemented with 115 sacks cement and 3% Calcium Chloride. Plug down at 3:00 P.M. October 19, 1963. Cut 7 7/8 in. hole to 2993' T.D. Hole dry and abandoned. Bottom plug set at 150 ft. with rock bridge of 20 sacks cement. Top plug set at 30 ft. with 8 sacks cement. 2 sacks in rathole. Hole plugging completed at 11:00 A.M. October 25, 1963 by Cecil Jones, State Plugger, McPherson, Kansas.

TOPS: Brown Lime - 2265' Kansas City - 2317' Mississippi - 2935'

Measurements taken from K.B.

CERTIFICATE

I, H. J. Flouffe, President of Blackstone Drilling, Inc., do hereby certify that the above and foregoing is a true and correct copy of log on the Decker #1, located on Sec. 11-20-2N, McPherson County, Kansas as reflected by files of the Blackstone Drilling, Inc.

H. J. Flouffe
 H. J. Flouffe, President

Subscribed and sworn to before me a Notary Public, within and for McPherson County, Kansas this 25th day of October, 1963.

Ruth McVay
 Ruth McVay - Notary Public

My Commission Expires: Dec. 18, 1965.