


Give All Information Completely  
Make Required Affidavit  
Mail or Deliver Report to:  
Conservation Division  
State Corporation Commission  
800 Bittling Building  
Wichita, Kansas

WELL PLUGGING RECORD

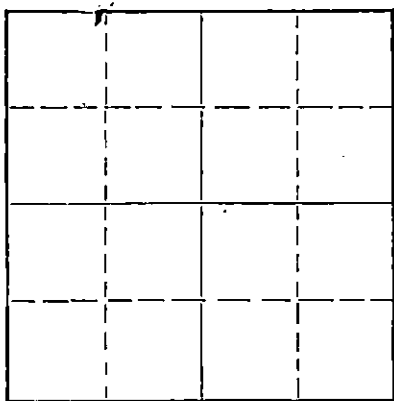

Locate well correctly on above Section Plat

McPherson County. Sec. 8 Twp. 20S Rge. 2 (E) 2 (W)  
Location as "NE/CNWSWK" or footage from lines NE SE SE  
Lease Owner Musgrove Petroleum Corporation  
Lease Name D. W. Koehn Well No. 1  
Office Address 518 Petroleum Building, Wichita, Kansas.  
Character of Well (completed as Oil, Gas or Dry Hole) Dry Hole  
Date well completed March 9, 19 54  
Application for plugging filed verbally March 9, 19 54  
Application for plugging approved verbally March 9, 19 54  
Plugging commenced March 9, 19 54  
Plugging completed March 9, 19 54  
Reason for abandonment of well or producing formation Dry hole

If a producing well is abandoned, date of last production \_\_\_\_\_ 19 \_\_\_\_  
Was permission obtained from the Conservation Division or its agents before plugging was commenced? Yes

Name of Conservation Agent who supervised plugging of this well Mr. Ruel Durkee, Box 597, McPherson, Ks.  
Producing formation \_\_\_\_\_ Depth to top \_\_\_\_\_ Bottom \_\_\_\_\_ Total Depth of Well 3005 Feet  
Show depth and thickness of all water, oil and gas formations.

OIL, GAS OR WATER RECORDS

CASING RECORD

FORMATION	CONTENT	FROM	TO	SIZE	PUT IN	PULLED OUT
				8-5/8"	158'	

Describe in detail the manner in which the well was plugged, indicating where the mud fluid was placed and the method or methods used in introducing it into the hole. If cement or other plugs were used, state the character of same and depth placed, from \_\_\_\_\_ feet to \_\_\_\_\_ feet for each plug set.

Filled hole with heavy mud to 156'.  
Set first plug at 156' with 15 sacks cement.  
Filled hole with heavy mud to 18'.  
Set second plug at 18' with 5 sacks cement.

(If additional description is necessary, use BACK of this sheet)  
Name of Plugging Contractor Musgrove Petroleum Corporation,  
Address 518 Petroleum Building, Wichita, Kansas.

STATE OF Kansas, COUNTY OF Sedgwick  
I, Gordon L. Koelling (employee of owner) or (owner or operator) of the above-described well, being first duly sworn on oath, says: That I have knowledge of the facts, statements, and matters herein contained and the log of the above-described well as filed and that the same are true and correct. So help me God.

(Signature) Gordon L. Koelling  
518 Petroleum Building, Wichita, Kans.  
(Address)

SUBSCRIBED AND SWORN TO before me this 16th day of March, 1954

My commission expires July 16, 1955

**PLUGGING**  
FILE SEC. 8 T 20 R 2W  
BOOK PAGE 19 LINE 14

**REC-111**  
STATE CORPORATION COMMISSION  
MAR 18 1954  
Notary Public  
CONSERVATION DIVISION  
Wichita, Kansas

CONTRACTOR'S WELL LOG

COMPANY:	Musgrove Petroleum Corporation
CONTRACTOR:	Musgrove Petroleum Corporation
FARM:	D. W. KOEHN #1
LOCATION:	NE SE SE, Section 8-20S-2W McPherson County, Kansas
COMMENCED:	March 1, 1954
COMPLETED:	March 9, 1954

0	158	Surface soil, clay & shale
158	510	Shale, shells & lime streaks
510	965	Shale & lime
965	1475	Shale & shells
1475	1685	Shale & lime streaks
1685	2980	Shale & lime
2980	3005	Chert & lime
	3005	Rotary Total Depth

Set 8-5/8" surface at 158' with 160 sacks of cement and 2 calcium chloride.

Dry and Abandoned.

STATE OF KANSAS }  
COUNTY OF SEDGWICK } SS

I, GORDON L. KOELLING, do hereby certify that the above and foregoing is a true and correct copy of the log of the D. W. KOEHN #1, NE SE SE, Section 8-20S-2W, McPherson County, Kansas, as reflected by the files of the Musgrove Petroleum Corporation.

MUSGROVE PETROLEUM CORPORATION

BY Gordon L. Koelling  
Secretary-Treasurer

Subscribed and sworn to before me, a Notary Public, in and for Sedgwick County, Kansas, this 16th day of March, 1954.

Alma C. Ross  
Notary Public

My commission expires July 16, 1955

STATE CORP. DIV.  
MAR 18 1954  
CONSERVATION DIVISION  
Wichita, Kansas

PLUGGING  
FILE SEC 8-20R-2W  
BOOK PAGE 19 LINE 14