


WELL PLUGGING RECORD

Give All Information Completely
Make Required Affidavit
Mail or Deliver Report to:
Conservation Division
State Corporation Commission
212 North Market, Insurance Bldg.
Wichita, Kansas

NORTH

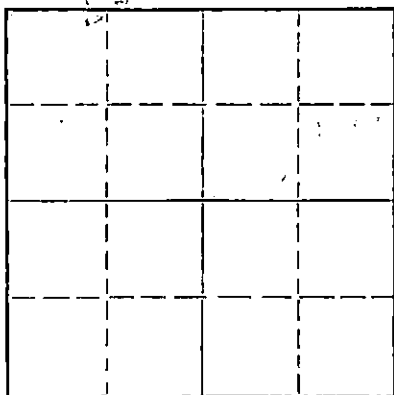

Locate well correctly on above
Section Plat

McPherson County, Sec. 6 Twp. 20S Rge. (E) 2 (W)
Location as "NE/CNW/SW" or footage from lines NE SE SE
Lease Owner Acme Oil Corp.
Lease Name Osborne Well No. 1
Office Address 404 One Twenty Bldg, Wichita, Kansas
Character of Well (completed as Oil, Gas or Dry Hole) Dry Hole
Date well completed November 23, 19 64
Application for plugging filed November 23, 19 64
Application for plugging approved November 23, 19 64
Plugging commenced November 23, 19 64
Plugging completed November 23, 19 64
Reason for abandonment of well or producing formation No commercial shows

If a producing well is abandoned, date of last production 19
Was permission obtained from the Conservation Division or its agents before plugging was commenced? yes

Name of Conservation Agent who supervised plugging of this well Gilbert Toman
Producing formation none Depth to top Bottom Total Depth of Well 3430 Feet
Show depth and thickness of all water, oil and gas formations.

OIL, GAS OR WATER RECORDS

CASING RECORD

FORMATION	CONTENT	FROM	TO	SIZE	PUT IN	PULLED OUT

Describe in detail the manner in which the well was plugged, indicating where the mud fluid was placed and the method or methods used in introducing it into the hole. If cement or other plugs were used, state the character of same and depth placed, from feet to feet for each plug set.

Mudded hole with 42 viscosity mud to 150 feet.
Set plug @ 150 feet. Added 25 sacks cement.
Mudded hole with 42 viscosity mud to 40 feet.
Set plug. Added 10 sacks cement. Capped rat hole
with 2 sacks cement.

RECEIVED
STATE CORPORATION COMMISSION

NOV 25 1964

CONSERVATION DIVISION
Wichita, Kansas

(If additional description is necessary, use BACK of this sheet)

Name of Plugging Contractor Canaday Drilling Company
Address 6427 East Kellogg, Wichita, Kansas

STATE OF KANSAS, COUNTY OF SEDGWICK, ss.
Granville E. Canaday (employee of owner) or (owner or operator) of the above-described well, being first duly sworn on oath, says: That I have knowledge of the facts, statements, and matters herein contained and the log of the above-described well as filed and that the same are true and correct. So help me God.

(Signature) Granville E. Canaday
6427 East Kellogg, Wichita, Kansas
(Address)

SUBSCRIBED AND SWORN TO before me this 24th day of November, 19 64

My commission expires Feb. 18, 1968

Kareta S. Math

Notary Public.

My commission expires



WELL LOG

COMPANY: Acme Oil Corp.
404 One Twenty Bldg.
Wichita, Kansas

COMMENCED: November 10, 1964

COMPLETED: November 23, 1964

LEASE: OSBORNE #1

TOTAL DEPTH: 3430

LOCATION: NE SE SE Sec. 6-20S-2W
McPherson County, Kansas

ELEVATION:

CONTRACTOR: Canaday Drilling Company
6427 East Kellogg
Wichita, Kansas

CASING: 154 feet of 8 5/8 inch with 150 sacks cement.

FIGURES INDICATE BOTTOM OF FORMATION

15	Top soil	2275	Sand and sandy shale
35	Sand	2351	Sand and shale
130	Shale	2730	Lime
154	Shale and lime	2835	Shale
410	Shale	2930	Shale with lime strks.
884	Lime with shale strks.	3006	Shale - lime
1180	Shale - lime	3198	Lime
1890	Shale with lime strks.	3220	Shale
1998	Shale - lime	3272	Shale - lime
2086	Lime	3394	Shale
		3430	Dolomite

RECEIVED
STATE CORPORATION COMMISSION

NOV 25 1964

CONSERVATION DIVISION
Wichita, Kansas

I, Granville E. Canaday, of the
CANADAY DRILLING COMPANY certify
the above Well Log to be true to
the best of my knowledge.

Granville E. Canaday
Granville E. Canaday

Subscribed and sworn to before me, a Notary Public in and for Sedgwick County,
Kansas this 24th day of November, 1964.

Loretta S. Watts