

Give All Information Completely
Make Required Affidavit
Mail or Deliver Report to:
Conservation Division
State Corporation Commission
800 Bitting Building
Wichita, Kansas

NORTH

Locate well correctly on above Section Plat

Barton County. Sec. 9 Twp. 16 Rge. (E) 13 (W)
Location as "NE $\frac{1}{4}$ NW $\frac{1}{4}$ SW $\frac{1}{4}$ " or footage from lines SW SE SE
Lease Owner Cities Service Oil Co SW
Lease Name Daniel Well No. 3
Office Address Dartlesville OKla
Character of Well (completed as Oil, Gas or Dry Hole) Oil Well
Date, well completed May 21 1937
Application for plugging filed May 17 1941
Application for plugging approved May 19 1941
Plugging Commenced May 25 1941
Plugging Completed May 29 1941
Reason for abandonment of well or producing formation UN Profitable

If a producing well is abandoned, date of last production May 1941
Was permission obtained from the Conservation Division or its agents before plugging was commenced? Yes

Name of Conservation Agent who supervised plugging of this well A. T. Alexander
Producing formation Arbuckle Depth to top 3387 Bottom Total Depth of Well 3392 Feet
Show depth and thickness of all water, oil and gas formations.

OIL, GAS OR WATER RECORDS


CASING RECORD

Formation	Content	From	To	Size	Put In	Pulled Out
<u>Arbuckle</u>	<u>Oil & water</u>			<u>10 3/4</u> <u>7" O.D.</u>	<u>368'</u> <u>3388</u>	<u>None</u> <u>3640'</u>

Describe in detail the manner in which the well was plugged, indicating where the mud fluid was placed and the method or methods used in introducing it into the hole. If cement or other plugs were used, state the character of same and depth placed, from _____ feet to _____ feet for each plug set.

Filled with Mud 3399 to 3394' Set wood plug @ 3394'
dumped 15' Cement Mud to 3391' set wood plug dumped
15' Cement Mud to 14' dumped 11' Cement Mud + DIRT to
Surface.

PLUGGING
FILE SE-9-16-13W
BOOK PAGE 138 LINE 6

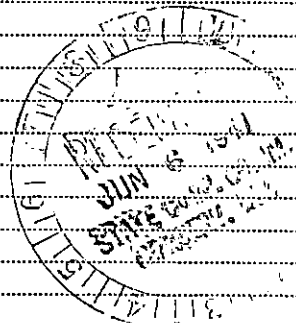

(If additional description is necessary, use BACK of this sheet)

Correspondence regarding this well should be addressed to Mr. R. G. Hauber
Address Cities Service Oil Co. Great Bend, Ks.

STATE OF Kansas, COUNTY OF Russell, ss.
J. A. Cleverley (employee of owner) or (owner or operator) of the above-described well,

being first duly sworn on oath, says: That I have knowledge of the facts, statements and matters herein contained and the log of the above-described well as filed and that the same are true and correct. So help me God.

(Signature) J. A. Cleverley
Address Russell Kansas

SUBSCRIBED AND SWORN to before me this 4 day of June, 1941.

My commission expires Jan. 26 1942
R. J. Turner Notary Public.

15-009-16117-0000
SUSESH

WELL RECORD

Company Empire Oil & Refg. No. 3 Farm Demol

Location 330°N - 991°W of S/4 Cor. Sec. 9 Twp. 16 Rge. 13W

Elevation _____ County Barton State Kansas

Date Commenced: 4-23-37

Date Completed 5-21-37 Initial Production 1257 bbls. in 24 hrs. after acid. 0 wtr.

Drid. by R.W. Rine Drlg. Co. T.D. 3392'

-Fillup-

150' oil in 1/2 hour.
450' oil in 2 1/2 hours.
1400' oil in 4 hours.
1700' oil in 4 1/2 hours.
1900' oil in 5 hours.
2700' oil in 8 hours.
2800' oil in 10 hours.

Acidized with 1000 gals. 5-23-37.

Straight Hole Tests

500'	00
1600'	00
2225'	0
2925'	0
3300'	10

Casing Record:

10 1/2" 368' Cem. w/ 300 sxs.
7" OD 3388' S.L.M. Cem. w/ 300 sxs.

Sand gravel	60
shale and lime shells	368
shale and sand	462
iron	494
red rock	631
red rock, anhydrite and shale	1014
shale and shells	1245
shale	1454
shale and shells	1609
shale and syp.	1679
broken lime	1751
shale and shells	1913
broken lime	2108
broken lime and shale	2174
shale and shells	2247
broken lime	2493
shale	2563
shale and shells	2638
lime and shale	2700
shale and lime shells	2809
lime and shale	2876
lime	2945
lime and shale	3000
lime	3072
lime and shale	3135
sand and lime	3207
lime	3296
lime and shale	3343
sand and shale	3360
S.L.M. Corr.	3360=3349
lime	3378
shale and lime	3382
shale cored	3387
lime cored	3391
S.L.M. Corr.	3391=3389
lime	3392

Top Siliceous 3387' S.L.M.
Penetration 5'
T.D. 3392'

PLUGGING
FILE 9. 16 13W
BOOK PAGE 138 LINE 6

RECEIVED
MAY 23 1937
BARTON COUNTY

15-009-16117-0000



CITIES SERVICE OIL COMPANY

PRODUCERS-REFINERS-MARKETERS OF PETROLEUM PRODUCTS

BARTLESVILLE
OKLAHOMA

Great Bend, Kansas
June 5, 1941

State Corporation Commission
Conservation Division
800 Bitting Building
Wichita, Kansas

Gentlemen:

Attached herewith is Well Plugging Record of the work done in connection with plugging and abandoning our Demel well No. 3, Section 9-16-13W, Barton County, Kansas.

Very truly yours,

CITIES SERVICE OIL COMPANY

R. C. Hauber

EH:
Attach.

PLUGGING
FILE # 9-16-13W
BOOK PAGE 138 of 14

