


Give All Information Completely  
Make Required Affidavit  
Mail or Deliver Report to:  
Conservation Division  
State Corporation Commission  
211 No. Broadway  
Wichita, Kansas

WELL PLUGGING RECORD

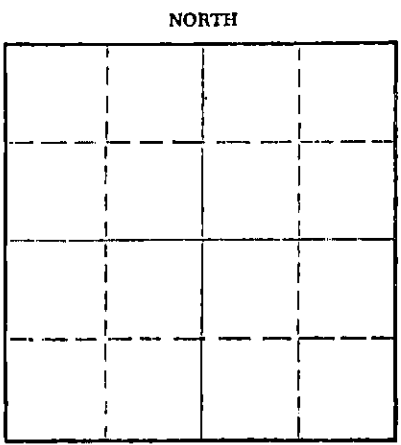

Locate well correctly on above  
Section Plat

Pawnee County. Sec. 29 Twp. 20 Rge. 20 (E) W (W)  
Location as "NE/CNW/WSW" or footage from lines C SW NE  
Lease Owner Tomlinson-Kathol, Inc.  
Lease Name Saxton Well No. 1  
Office Address 1125 Wichita Plaza, Wichita, Kansas  
Character of Well (completed as Oil, Gas or Dry Hole) D & A  
Date well completed April 28, 1965  
Application for plugging filed April 28, 1965  
Application for plugging approved April 28, 1965  
Plugging commenced April 28, 1965  
Plugging completed April 28, 1965  
Reason for abandonment of well or producing formation No commercial quantities of oil or gas encountered.  
If a producing well is abandoned, date of last production 19  
Was permission obtained from the Conservation Division or its agents before plugging was commenced? yes

Name of Conservation Agent who supervised plugging of this well Eldon Petty  
Producing formation None Depth to top \_\_\_\_\_ Bottom \_\_\_\_\_ Total Depth of Well 4382 Feet  
Show depth and thickness of all water, oil and gas formations.

OIL, GAS OR WATER RECORDS

CASING RECORD

FORMATION	CONTENT	FROM	TO	SIZE	PUR IN	PULLED OUT
Surface				8 5/8"	467 ft	None

Describe in detail the manner in which the well was plugged, indicating where the mud fluid was placed and the method or methods used in introducing it into the hole. If cement or other plugs were used, state the character of same and depth placed, from \_\_\_\_\_ feet to \_\_\_\_\_ feet for each plug set.

Heavy mud was put into the hole to a depth of 460 feet, where the bottom plug was set and cemented with 20 sacks of cement. Mud was then put into the hole to a depth of 240 feet, where the middle plug was set and cemented with 20 sacks cement. Mud was again put into the hole to a depth of 40 feet, where the top plug was set and cemented with 10 sacks cement. Surface casing was cut off below ground level, and the location abandoned.

RECEIVED  
STATE CORPORATION COMMISSION

MAY 7 1965

(If additional description is necessary, use BACK of this sheet)  
Name of Plugging Contractor Tom Kat, Inc.  
Address 1125 Wichita Plaza, Wichita, Kansas

CONSERVATION DIVISION  
Wichita, Kansas

STATE OF KANSAS COUNTY OF SEDGWICK, ss.  
Richard C. Davis, (employee of owner) or (owner or operator) of the above-described

well, being first duly sworn on oath, says: That I have knowledge of the facts, statements, and matters herein contained and the log of the above-described well as filed and that the same are true and correct. So help me God.

(Signature) [Signature]  
1125 Wichita Plaza, Wichita, Kansas  
(Address)

SUBSCRIBED AND SWORN to before me this 5th day of May, 1965

[Signature]  
Notary Public.

My commission expires January 19, 1969

## DRILLER'S LOG

# 1 GANTON

TOLINSON-KATHOL, INC.

C S. 1/4, Sec. 29-203-20  
Pawnee County, KansasCommenced: 4/17/65  
Completed: 4/27/65  
Elevation: 2158 KD

From	To	Description	Remarks
0	162	Sand & Shale	467' 8 5/8" Surface Casing with 275 sacks Sunset cement.
162	467	Sand & Shale	
467	773	Shale red bed	
773	880	Sand	<u>Tops:</u>
880	1348	Sand & Shale	
1348	1378	Anhydrite	Top Heebner 3697 -1539
1378	2352	Shale	Top Lansing 3753 -1595
2352	3215	Shale & Lime	Top Fort Scott 4256 -2098
3215	3605	Shale	Top Conglomerate Chert 4310 -2152
3605	3854	Shale & Lime	Top Mississippian 4330 -2172
3854	3907	K. C. Lime	Top Mississippian Lime 4372 -2214
3907	4142	Lime	Rotary Total Depth 4382 -2224
4142	4302	Lime & Shale	
4302	4332	Conglomerate	
4332	4382	Mississippian	
4382		Total Depth	

I certify to the best of my knowledge and belief, the above represents a true and accurate driller's log record of the captioned well.

RECEIVED  
STATE CORPORATION COMMISSION

*Gerald J. Kathol*  
Gerald J. Kathol

MAY 7 1965

CONSERVATION DIVISION  
Wichita, Kansas

STATE OF KANSAS

SS

COUNTY OF SEDGWICK

Subscribed and sworn to before me this 3rd day of May, 1965.

*Esther Lamone*  
Esther Lamone, Notary Public

My Commission Expires: Jan. 19, 1969