

Give All Information Completely
Make Required Affidavit
Mail or Deliver Report to:
Conservation Division
State Corporation Commission
212 No. Market
Wichita, Kansas

WELL PLUGGING RECORD

Pawnee County, Sec. 31 Twp. 20S Rge. 20 (E) W (W)

Location as "NE/CNWxSWx" or footage from lines 150' NW of Cen. NE SW

Lease Owner Birmingham-Bartlett Drilling Co.

Lease Name TOMBAUGH Well No. 2

Office Address 300 Kaufman Building, Wichita, Kansas 67202

Character of Well (completed as Oil, Gas or Dry Hole) Dry Hole

Date well completed April 15, 19 67

Application for plugging filed (verbally) April 15, 19 67

Application for plugging approved (verbally) April 15, 19 67


Plugging commenced April 15, 19 67

Plugging completed April 15, 19 67

Reason for abandonment of well or producing formation Dry Hole

If a producing well is abandoned, date of last production 19

Was permission obtained from the Conservation Division or its agents before plugging was commenced? Yes.

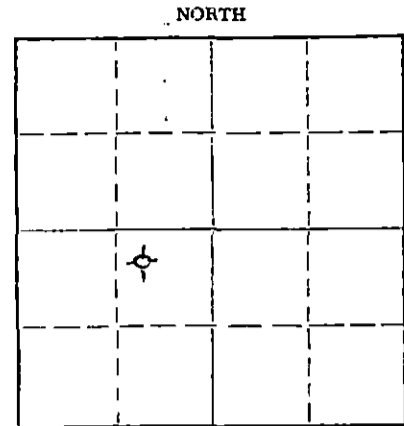

Locate well correctly on above Section Plat

Name of Conservation Agent who supervised plugging of this well Leo F. Massey

Producing formation Depth to top Bottom Total Depth of Well 4387 Feet

Show depth and thickness of all water, oil and gas formations.

OIL, GAS OR WATER RECORDS

CASING RECORD

FORMATION	CONTENT	TO	SIZE	PUT IN	PULLED OUT
	RECEIVED STATE CORPORATION COMMISSION APR 19 1967 CONSERVATION DIVISION WICHITA, KANSAS	256'	8-5/8"	256'	none

Describe in detail the manner in which the well was plugged, indicating where the mud fluid was placed and the method or methods used in introducing it into the hole. If cement or other plugs were used, state the character of same and depth placed, from feet to feet for each plug set.

Bottom plug set at 540' with 25 sacks cement.
Center plug set at 250' with 20 sacks cement.
Top plug set at 40' with 8 sacks cement.
2 sacks cement in rat hole.

(If additional description is necessary, use BACK of this sheet)

Name of Plugging Contractor Birmingham-Bartlett Drilling Co.
Address 300 Kaufman Building, Wichita, Kansas 67202

STATE OF KANSAS, COUNTY OF SEDGWICK
Richard Hindery, Partner of Birmingham-Bartlett Drilling Co., owner, operator, & contractor
(employee of owner) or (owner or operator) of the above-described well, being first duly sworn on oath, says: That I have knowledge of the facts, statements, and matters herein contained and the log of the above-described well as filed and that the same are true and correct. So help me God. BIRMINGHAM-BARTLETT DRILLING CO.

(Signature) By Richard Hindery
300 Kaufman Building, Wichita, Kansas 67202
(Address)

SUBSCRIBED AND SWORN TO before me this 18th day of April, 19 67.

My commission expires October 2, 1970.

Beverly Larson
Beverly Larson Notary Public.

TOMBAUGH NO. 2 WELL

LOCATION: 150' NW of Cen. NE/4 SW/4 Section 31-20S-20W Pawnee County, Kansas
 SPUDED: 4- 6-67
 COMPLETED: 4-15-67

OWNER, OPERATOR, and CONTRACTOR: Birmingham-Bartlett Drilling Co. 300 Kaufman Building Wichita, Kansas 67202

SURFACE CASING: 8-5/8" casing cemented at 256' with 170 sacks cement.

OIL STRING: None set. Dry hole. Plugged 4-15-67.

RECEIVED
 STATE CORPORATION COMMISSION

APR 19 1967

CONSERVATION DIVISION
 Wichita, Kansas

LOG

(Figures indicate bottom of formation)

0 - 40	Rock
256	Shale and shells
707	Shale and Sand
717	Blaine Anhydrite
810	Shale and Sand
1020	Sand
1368	Red Bed
1397	Anhydrite
1464	Shale and Red Bed
2100	Shale and Shells
2490	Lime and shale
2605	Lime
3800	Lime and Shale
4387	Lime
4387	Rotary total depth Dry hole

The undersigned, Richard Hindery, one of the partners of Birmingham-Bartlett Drilling Co., hereby certifies that the above is a true and correct log of the TOMBAUGH NO. 2 WELL as shown in the daily drilling reports.

BIRMINGHAM-BARTLETT DRILLING CO.

By Richard Hindery
 Richard Hindery, Partner

Subscribed and sworn to before me
 this 18th day of April, 1967.

Beverly Larson

Beverly Larson, Notary Public

My commission expires October 2, 1970.