

STATE OF KANSAS  
STATE CORPORATION COMMISSION

WELL PLUGGING RECORD

Give All Information Completely  
Make Required Affidavit  
Mail or Deliver Report to  
Conservation Division  
State Corporation Comm.  
245 North Water  
Wichita, KS 67202

Pawnee County, Sec. 31 Twp. 20S Rge. 20W E/W  
Location as "NE/CNW $\frac{1}{4}$ /SW $\frac{1}{4}$ " or footage from lines  
NE NW

Lease Owner PICKRELL DRILLING COMPANY  
Lease Name MILLER "F" Well No. 1  
Office Address 205 LITWIN BLDG., WICHITA, KS. 67202  
Character of Well (Completed as Oil, Gas or Dry Hole) Dry Hole


Date Well completed 3-21-79 19  
Application for plugging filed 3-21-79 19  
Application for plugging approved 3-21-79 19  
Plugging commenced 3-21-79 19  
Plugging completed 3-21-79 19

Reason for abandonment of well or producing formation  
Dry Hole

If a producing well is abandoned, date of last production 19

Was permission obtained from the Conservation Division or its agents before plugging was commenced? Yes

Name of Conservation Agent who supervised plugging of this well  
Producing formation \_\_\_\_\_ Depth to top \_\_\_\_\_ Bottom \_\_\_\_\_ Total Depth of Well 4390'  
Show depth and thickness of all water, oil and gas formations.

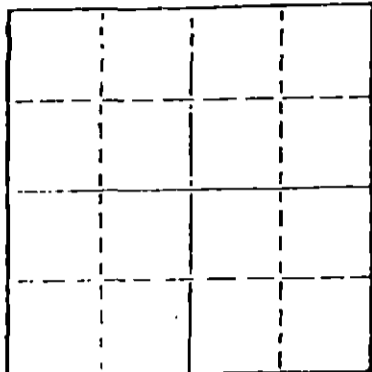

Locate well correctly on above Section Plat

OIL, GAS OR WATER RECORDS

CASING RECORD

FORMATION	CONTENT	FROM	TO	SIZE	PUT IN	PULLED OUT
				8 5/8	220	None

Describe in detail the manner in which the well was plugged, indicating where the mud fluid was placed and the method or methods used in introducing it into the hold. If cement or other plugs were used, state the character of same and depth placed, from \_\_\_\_\_ feet to \_\_\_\_\_ feet for each plug set.

50 sacks at 550'  
25 sacks at 200'  
10 sacks at 40'  
2 sacks in Rathole Comp. 6:15PM 3-21-79

RECEIVED  
STATE CORPORATION COMMISSION

MAR 28 1979

(If additional description is necessary, use BACK of this sheet)  
Name of Plugging Contractor Pickrell Drilling Company  
Wichita, Kansas

STATE OF Kansas COUNTY OF Sedgwick, ss.  
C. W. Sebitts (employee of owner) or (owner or operator)

of the above-described well, being first duly sworn on oath, says: That I have knowledge of the facts, statements, and matters herein contained and the log of the above-described well as filed and that the same are true and correct. So help me God. By: C. W. Sebitts

(Signature) *C. W. Sebitts*  
205 LITWIN BLDG., WICHITA, KS. 67202  
(Address)

SUBSCRIBED AND SWORN TO before me this 26 day of March, 1979

My commission expires 2-18-80

*Jo Ann Sarver*  
Notary Public.  
Jo Ann Sarver



ROTARY DRILLING LOG

15.145.20581.0000

COMPANY: PICKRELL DRILLING COMPANY
205 LITWIN BLDG.
WICHITA, KS. 67202
LOCATION: Miller "F" #1
NE NW Sec. 31-20S-20W
Pawnee County, Kansas

Rotary Drilling Commenced 3-11-79
Rotary Drilling Completed 3-21-79

CONTRACTOR: PICKRELL DRILLING COMPANY
Wichita, Kansas

CASING RECORD: Surf. casing 8 5/8" set at 220' with 145 sacks Comp. 9:30PM 3-11-79

LOG

(Figures indicate bottom of formation — measurements from top of rotary bushing.)

Table with 2 columns: Formation Type and Depth. Rows include Top Soil & Shale (20), Post Rock (65), Shale (220), Shale & Sand (420), Shale & Sand (825), Sand (1020), Shale & Sd. Strgs. (1335), Shale (1382), Shale (1412), Shale (1640), Shale & Lime (2120), Lime & Shale (2295), Lime & Shale (2480), Lime & Shale (2670), Lime & Shale (2845), Lime & Shale (3000), Lime & Shale (3150), Lime & Shale (3310), Lime & Shale (3470), Lime & Shale (3640), Lime & Shale (3820), Lime & Shale (3960), Lime & Shale (4090), Lime (4200), Lime (4280), Lime (4335), Lime (4366), Lime (4374), Lime (4380), Lime (4390).

RECEIVED STATE CORPORATION COMMISSION MAR 28 1979 CONSERVATION DIVISION Wichita, Kansas

The undersigned, C. W. Sebitts, Attorney-in-Fact for PICKRELL DRILLING COMPANY, hereby certifies in behalf of said Company, that the above is a true and correct log of the formation encountered in drilling the above well as reflected by the Daily Drilling Reports.

PICKRELL DRILLING COMPANY
By [Signature] Attorney-in-Fact

STATE OF KANSAS }
COUNTY OF SEDGWICK } ss.:

C. W. Sebitts

On this 26 day of March, 1979, before me the undersigned, a Notary Public, in and for the County and State aforesaid, personally appeared C. W. Sebitts, to me known to be the identical person who subscribed the name of PICKRELL DRILLING COMPANY to the foregoing instrument as its Attorney-in-Fact and acknowledged to me that he executed the same as his free and voluntary act and deed, and as the free and voluntary act and deed of such company, for the uses and purposes therein set forth.

Given under my hand and seal of office the day and year last above written.

My commission expires: 2-18-80

[Signature] Notary Public
Jo Ann Sarver

