


STATE OF KANSAS
STATE CORPORATION COMMISSION

WELL PLUGGING RECORD

Give All Information Completely
Make Required Affidavit
Mail or Deliver Report to:
Conservation Division
State Corporation Commission
212 N. Market
Wichita, Kansas

Pawnee County, Sec. 31 Twp. 20S Rge. (E) 20W(W)

Location as "NE/CNW/SW" or footage from lines 150' North of NW 1/4 SW 1/4
Lease Owner Birmingham - Bartlett Drilling Co., et al
Lease Name Tombaugh Well No. 1
Office Address 300 Kaufman Bldg., Wichita, Kansas, 67202
Character of Well (completed as Oil, Gas or Dry Hole) Oil Well
Date well completed October 19, 19 66
Application for plugging filed November 22, 19 72
Application for plugging approved November 27, 19 72
Plugging commenced November 30, 19 72
Plugging completed December 18, 19 72
Reason for abandonment of well or producing formation Production depleted to a point where well no longer economical to operate.
If a producing well is abandoned, date of last production November 26, 19 72
Was permission obtained from the Conservation Division or its agents before plugging was commenced? Yes

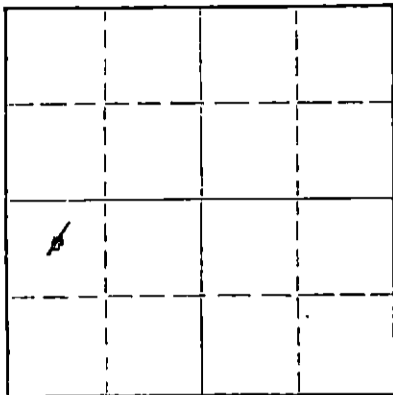

Locate well correctly on above Section Plat

Name of Conservation Agent who supervised plugging of this well Leo Massey
Producing formation Mississippi-Osage Depth to top 4365' Bottom _____ Total Depth of Well 4395 Feet
Show depth and thickness of all water, oil and gas formations.

OIL, GAS OR WATER RECORDS

CASING RECORD

FORMATION	CONTENT	FROM	TO	SIZE	PUT IN	PULLED OUT
		0	254	8-5/8"	257'	None
		0	4369'	5-1/2"	4369'	2424'
RECEIVED STATE CORPORATION COMMISSION UEC-2-6 1972 CONSERVATION DIVISION Wichita, Kansas						

Describe in detail the manner in which the well was plugged, indicating where the mud fluid was placed and the method or methods used in introducing it into the hole. If cement or other plugs were used, state the character of same and depth placed, from _____ feet to _____ feet for each plug set.

All work done, and pipe pulled as follows by Ralph Comstock pipe pulling Company, 320-North Park St. Stafford, Kansas, Permit # 490 and under the supervision of State Corp. Commission representative Mr. Leo Massey, Of Hays, Kansas.

TD. of Hole 4395', Sanded back with sand to 3975', Then set bridging plug, And dumped 5 sacks of cement on top of plug.

Shot pipe off at 2396'; Then pulled 2424' overall tally;

12-18-72

Halliburton Oil Well Cementing Co. mixed 25 sacks gel, and 5 sacks hulls Then 120- Sacks Posmix with 6% gel. To a standing pressure of 500#. When all was displaced and hole was full to the surface of the Cellar; There was a plate welded on 8 5/8" casing.


(If additional description is necessary, use BACK of this sheet)
Name of Plugging Contractor Ralph Comstock Pipe Pulling Co. (Permit # 490)
Address 320 North Park Street, Stafford, Kansas;

STATE OF KANSAS COUNTY OF SEDGWICK
Chas. H. Keevert, Prod. Supt. of Birmingham - Bartlett Drilling Co., Operator & part owner
(employee of owner) or (owner or operator) of the above-described well, being first duly sworn on oath, says: That I have knowledge of the facts, statements, and matters herein contained and the log of the above-described well as filed and that the same are true and correct. So help me God.

(Signature) Chas. H. Keevert
Route 1, 1806 Tracy Lane, Hutchinson, Ks. 67500
(Address)

SUBSCRIBED AND SWORN TO before me this 22nd day of December, 19 72

My commission expires November 29, 1974

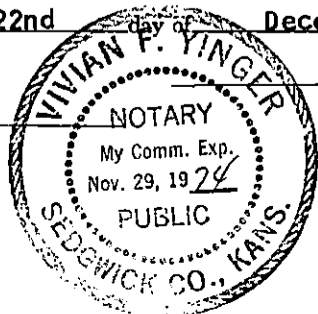

Vivian F. Yinger
Notary Public.

ACTUAL REPORT BY KEEVERT. ON 10-14-66 DRILLER'S SHEET ON TOME H #1

RE: OIL STRING:

Ran 55 Jts. 5-1/2" OD 14# New & Used J-55 R-2 Casing = 2975'
Ran 42 Jts. 5-1/2" OD 1" New X Tru Coat (plastic-coated) casing - 1393'

Float Jt. 34' long, sun cemented with 125 sacks common, plug down to float at 4335'
at 6:20 PM 10-14-66.

RECEIVED
STATE CORPORATION COMMISSION

NOV 27 1972

CONSERVATION DIVISION
Wichita, Kansas

TOMBAUGH NO. 1 WELL

LOCATION: 150' North of Cen. NW $\frac{1}{4}$, SW $\frac{1}{4}$
Sec. 31-20S-20W
Pawnee County, Kansas

SPUDED: 10-5-66

DRILLING FINISHED: 10-13-66

OWNER, OPERATOR
and CONTRACTOR: Birmingham-Bartlett Drilling Co.
300 Kaufman Building
Wichita, Kansas, 67202

SURFACE CASING: 8-5/8" 24# surface casing set at
254' with 175 sacks cement.

OIL STRING: 5-1/2" casing set at 4369' with 125
sacks cement.

L O G

(Figures indicate bottom of formation)

0 -	40	Sand Rock
	725	Shale and Shells
	736	Blaine Anhydrite
	1055	Sand
	1370	Shale and Red Bed
	1385	Red Bed Shale
	1415	Anhydrite
	2080	Shale and Shells
	2275	Shale and Lime
	3005	Lime and Shale
	3537	Shale and Lime
	3885	Lime and Shale
	4055	Lime
	4145	Lime and Shale
	4216	Lime
	4300	Lime with Shale
	4386	Lime
	4386	Rotary Total Depth

RECEIVED
STATE CORPORATION COMMISSION
NOV 27 1972
CONSERVATION DIVISION
Wichita, Kansas

The undersigned, Richard Hindery, one of the partners of Birmingham-Bartlett Drilling Co., hereby certifies that the above is a true and correct log of the TOMBAUGH NO. 1 WELL, as shown in the daily drilling reports.

BIRMINGHAM-BARTLETT DRILLING CO.

By

Richard Hindery
Richard Hindery, Partner

Subscribed and sworn to before me
this 18th day of October, 1966.

Vivian F. Yinger
Vivian F. Yinger, Notary Public

My commission expires November 29, 1966.