


Give All Information Completely  
Make Required Affidavit  
Mail or Deliver Report to:  
Conservation Division  
State Corporation Commission  
800 Bittor Building  
Wichita, Kansas

WELL PLUGGING RECORD

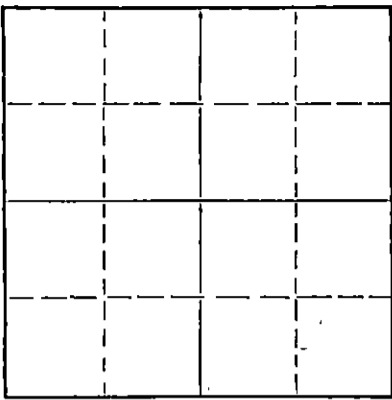

Locate well correctly on above  
Section Plat

McPherson County. Sec. 12 Twp. 20 Rge. 2 (E) W (W)  
Location as "NE/CNW/SW" or footage from lines SE/SE/NW  
Lease Owner John W. Gasebeer  
Lease Name Holmes Well No. 1  
Office Address 520 West Euclid  
Character of Well (completed as Oil, Gas or Dry Hole) Dry Hole  
Date well completed May 16, 1955  
Application for plugging filed filed by Durkee 1955  
Application for plugging approved September 1955  
Plugging commenced September 1 1955  
Plugging completed September 10, 1955  
Reason for abandonment of well or producing formation Dry Hole

If a producing well is abandoned, date of last production None 19      
Was permission obtained from the Conservation Division or its agents before plugging was commenced? Yes

Name of Conservation Agent who supervised plugging of this well Mr. Ruel Durkee  
Producing formation None Depth to top      Bottom      Total Depth of Well 2988 1/2 Feet  
Show depth and thickness of all water, oil and gas formations.

OIL, GAS OR WATER RECORDS

CASING RECORD

FORMATION	CONTENT	FROM	TO	SIZE	PUT IN	PULLED OUT
Chat. - Miss.				5 1/2"	2968	2580

Describe in detail the manner in which the well was plugged, indicating where the mud fluid was placed and the method or methods used in introducing it into the hole. If cement or other plugs were used, state the character of same and depth placed, from      feet to      feet for each plug set.

Fill hole with sand to 2925' dump 6 sack cement mud hole, bridge at 151' with rock & dump 15 sacks cement. Fill surface pipe dumped 5 sacks cement. Well completed.

RECEIVED  
STATE CORPORATION COMMISSION  
SEP 27 1955  
CONSERVATION DIVISION  
Wichita, Kansas

9-27-1955

(If additional description is necessary, use BACK of this sheet)  
Name of Plugging Contractor Harper Well Servicing  
Address Burton, Kansas

STATE OF Kansas, COUNTY OF McPherson, ss.  
John W. Gasebeer (employee of owner) or (owner or operator) of the above-described well, being first duly sworn on oath, says: That I have knowledge of the facts, statements, and matters herein contained and the log of the above-described well as filed and that the same are true and correct. So help me God.

(Signature) John W. Gasebeer  
Box 647 McPherson, Kansas (Address)

SUBSCRIBED AND SWORN TO before me this 21 day of Sept, 1955

My commission expires June 10, 1957

W. H. L. Luman  
Notary Public.

PLUGGING  
FILE SEC 12 T 20 R 2W  
BOOK PAGE 1 LINK 28

## ROTARY DRILLER'S LOG

Casebeer & Litan  
520 W. Euclid  
McPherson, Kansas

Holmes #1

SE SE NW/4  
Sec. 12-20-2W  
McPherson County, Kansas

Well Commenced: 4-28-55  
Well Completed: 5-16-55

Estimated  
Elevation: 1552 K.B.  
8-5/8" x 5 1/2" Spider 7'  
below K.B.

## Casing Record:

8-5/8" @ 151' 2/85 sks.  
Regular cement and 100%cc

5-1/2" 2968' 2/50 sks.  
Regular cement

Contractor: E. K. Carey Contractor, Rig #2 Box 660, McPherson, Kan.  
Geologist: Don J. Melland, Wichita, Kansas

Figures Indicate Bottom of Formation K. B.

Sub base and cellar	7	Geologist Tops:	
Soil and shale	35		
Sand	40	Kansas City	2304
Shale	100	Miss.	2928
Shells	103	Top Pay	2970
Shale	144		
Lime shells	151	Rotary Total Depth	2976
Shale and shells	350		
Anhydrite	310	Set 5 1/2" casing 8' off bottom	
Lime and shale	890	or 2968'	
Shale and lime	1375		
Lime and shale	1945		
Lime	2075		
Lime and shale	2090		
Sand and shale	2273		
Shale	2322		
K. C. Lime	2390		
Lime	2615		
Shale and lime	2675		
Lime and shale	2790		
Shale and lime	2928		
Miss. chat	2955		
Chat	2976 TD		

This is to certify that the above information is to the best of my knowledge true and correct.

**PLUGGING**  
 FILE SEC 12-20-2W  
 BOOK PAGE 1 LINE 28