


Give All Information Completely
Make Required Affidavit
Mail or Deliver Report to:
Conservation Division
State Corporation Commission
800 Bittling Building
Wichita, Kansas

NORTH

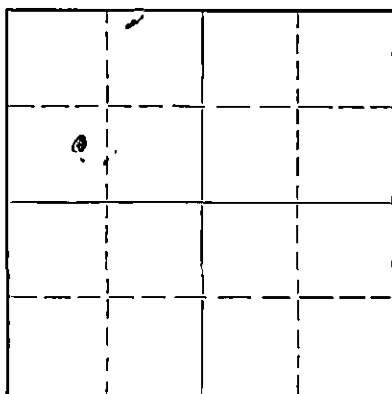

Locate well correctly on above
Section Plot

WELL PLUGGING RECORD

McPherson County. Sec. *12* Twp. *20* Rge. *2* (W)
Location as "NE/CW $\frac{1}{4}$ SW $\frac{1}{4}$ " or footage from lines *330 S. L. 990 W. L.*
Lease Owner *George R. Hess*
Lease Name *Hess* Well No. *1*
Office Address *505 N. C. HILES McPHERSON KAN.*
Character of Well (completed as Oil, Gas or Dry Hole) *DRY OIL WELL*
Date well completed *FEB 7* 19 *49*
Application for plugging filed *Sep 9* 19 *52*
Application for plugging approved *Sep 9* 19 *52*
Plugging commenced *Sep 15* 19 *52*
Plugging completed *Sep 25* 19 *52*
Reason for abandonment of well or producing formation
To M.C.H. SALT WATER
If a producing well is abandoned, date of last production *July 25* 19 *51*
Was permission obtained from the Conservation Division or its agents before plugging was commenced? *yes*

Name of Conservation Agent who supervised plugging of this well *Rule Durkee*
Producing formation *Chat* Depth to top *2951* Bottom *2983* Total Depth of Well *2983* Feet
Show depth and thickness of all water, oil and gas formations.

OIL, GAS OR WATER RECORDS

CASING RECORD

Formation	Content	From	To	Size	Put In	Pulled Out
<i>Surface</i>	<i>water</i>	<i>20</i>	<i>80</i>	<i>8 5/8</i>	<i>106</i>	<i>none</i>
<i>Chat</i>	<i>water & oil</i>	<i>2980</i>	<i>2983</i>	<i>5 1/2</i>	<i>2964</i>	<i>2115</i>

Describe in detail the manner in which the well was plugged, indicating where the mud fluid was placed and the method or methods used in introducing it into the hole. If cement or other plugs were used, state the character of same and depth placed, from _____ feet to _____ feet for each plug set.

2983 to 2964 Cemented. DUMP BAILER.
2964 to 2940 R.C.R.
2940 to 2940 6 sq wire dumped with Bailey
from 2900 to 275 2.5 sq Cement with heavy mud
top of cement to Surface with heavy mud from
5 sq in Base of Cellar.

RECEIVED
STATE CORPORATION COMMISSION

OCT 15 1952

CONSERVATION DIVISION
Wichita, Kansas

(If additional description is necessary, use BACK of this sheet)

Correspondence regarding this well should be addressed to
Address *505 N. Charles St*
McPherson Kans.

STATE OF _____, COUNTY OF _____, SS.

_____, (employee of owner) or (owner or operator) of the above-described well,
being first duly sworn on oath, says: That I have knowledge of the facts, statements, and matters herein contained and the log of the above-described well as filed and that the same are true and correct. So help me God.

(Signature)

George R. Hess
505 N Charles St McPherson Kan
(Address)

SUBSCRIBED AND SWORN TO before me this *17th* day of *October*, 19 *52*

Peter Amel

Notary Public.

My commission expires

June 5, 1953

23-3278-S

4-50-10M

PLUGGING
FILE SEC *12* P. *20* R. *20*
BOOK PAGE *12* LINE *12*

O. B. Holmes No. 1 Well

15.113.02029.0000

SE, SW, NW,
Section 12-20S-2W,
McPherson County, Kansas

Drilled for: P. G. Reynolds et al
Drilled by: Boardmore Drilling Company

Casing Record:

8-5/8" 106' w/75 skx
5-1/2" 2964'

Drilling Commenced: January 31, 1949.
Drilling Completed: February 7, 1949.

<u>FORMATION</u>	<u>DEPTH</u>
Soil-Clay	20
Sand-shale	80
Shale - shells	106
Lime - shale	415
Lime - shale	930
Shale - shells	1600
Shale - lime	1815
Lime - shale	2120
Sandy shale	2240
Lime - shale	2250
Lime broken	2480
Lime - shale	2961 $\frac{1}{2}$
Chat	2964 T. D.

STATE OF KANSAS

ss
COUNTY OF SEDGWICK

I, the undersigned, being duly sworn on oath, state that the above and within statement is a true and correct log and record of the well drilled on the location above-described, to the best of my knowledge and belief.

[Signature]

Subscribed and sworn to before me this 11th day of February, 1949.

[Signature]
Notary Public
Exp 9 - 1952

My Commission expires:

June 27, 1952.

REGISTRATION DIVISION
Topeka, Kansas

