


WELL PLUGGING RECORD

Give All Information Completely
Make Required Affidavit
Mail or Deliver Report to:
Conservation Division
State Corporation Commission
212 North Market, Insurance Bldg.
Wichita, Kansas

Mc Pherson County. Sec. 13 Twp. 20s Rge. 2w (E) (W)
Location as "NE/CNW%SW%" or footage from lines NW/4 NW/4 NE/4
Lease Owner Glickman Oil Co.
Lease Name J. Koehn Well No. I
Office Address P.O. Box 3104 Wichita, Kansas
Character of Well (completed as Oil, Gas or Dry Hole) oil
Date well completed October 7 1954
Application for plugging filed Aug 1961
Application for plugging approved Aug 1961
Plugging commenced Aug 22 1961
Plugging completed Aug 26 1961
Reason for abandonment of well or producing formation Went dry

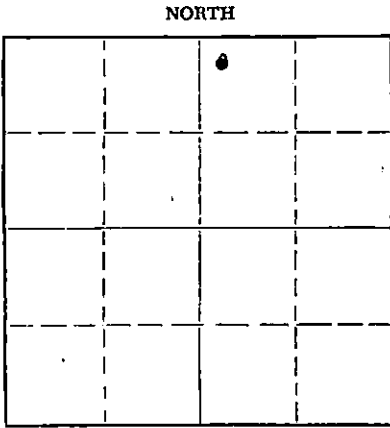

Locate well correctly on above Section Plat

If a producing well is abandoned, date of last production August 15 1961
Was permission obtained from the Conservation Division or its agents before plugging was commenced? yes

Name of Conservation Agent who supervised plugging of this well Cecil Jones
Producing formation _____ Depth to top _____ Bottom _____ Total Depth of Well 2986' Feet
Show depth and thickness of all water, oil and gas formations.

OIL, GAS OR WATER RECORDS

CASING RECORD

FORMATION	CONTENT	FROM	TO	SIZE	PUT IN	PULLED OUT
						I, 102

Describe in detail the manner in which the well was plugged, indicating where the mud fluid was placed and the method or methods used in introducing it into the hole. If cement or other plugs were used, state the character of same and depth placed, from _____ feet to _____ feet for each plug set.

Plugged off bottom of hole with rock. Rock from 2986' to 2870'. Dumped 5 sx of cement. Mudded hole to 170'. Set 20' ft. of rock bridge. Dumped 20 sx of cement. Finished mudding hole to 34'. Made 10' of rock bridge. Dumped 8 sx of cement, filling to the bottom of the cellar.

RECEIVED
STATE CORPORATION COMMISSION
SEP 12 1961
CONSERVATION DIVISION
Wichita, Kansas

(If additional description is necessary, use BACK of this sheet)

Name of Plugging Contractor Art Lamb Casing Pulling Co.
Address P.O. Box 983 Hutchinson, Kansas

STATE OF Kansas COUNTY OF Sedgwick, ss.
Milton Glickman (employee of owner) or owner or operator of the above-described well, being first duly sworn on oath, says: That I have knowledge of the facts, statements, and matters herein contained and the log of the above-described well as filed and that the same are true and correct. So help me God.

(Signature) [Signature]
Box 3104, Wichita 2, Kansas
(Address)

SUBSCRIBED AND SWORN TO before me this 8th day of September, 1961

My commission expires November 19, 1963

Lorella Schauf
Lorella Schauf, Notary Public.



15.113.01382.0000

Plug Permit Filed 7/25/61
Comm - Sept 27, 1954
Comp - Oct 7, 1954

GLICKMAN OIL COMPANY

433 ST. FRANCIS PHONE 2-6418

WICHITA 2, KANSAS

Koehn #1

NW NW NE - 13-20-2W

Koehn Lease
McPherson County, Kansas

Wednesday, October 13, 1954 -

Moved in. Swabbed Hole. Dry Drilled 14' of Cement. Bottom of Cement 2976 - Ground level. Pipe Bottom 2984' - 1 ft. off bottom. 75 Sacks Cement. - 6' Cement left in Pipe.

Thursday, October 14, 1954

12:00 Noon	- Perforated 3 holes 2923½' to 2924½'. Gun came out oily, ran boiler - recovered good show of oil, no water, plenty of gas.
1:00 P.M.	1 hr. test - 112' oil in hole - no water.
1:30 P.M.	Perforated 18 shots 2923½ to 2926'. Increase of Gas.
3:30 P.M.	Ran Swab to clean hole. Pulled 4½ Bbls. oil in tank.
4:30 P.M.	3 3/4" to 6½" -- 2 3/4" --- 4.50 Bbls.
5:30 P.M.	6½" to 9" -- 2½" --- 4.17 "
6:30 P.M.	9" to 11¼" -- 2¼" -- 3.75 "
7:30 P.M.	11¼" to 13¼" -- 2" -- 3.34 "
8:30 P.M.	2" -- 3.34 "
9:30 P.M.	1 3/4" --- 2.92 "
10:30 P.M.	1 3/4" --- 2.92 "

Friday, October 15, 1954

8:00 A.M. Well Spraying Oil. Tank measured 19½". Swabbed hole down. - Tank measured 30".

9:40		
XXXX A.M.		1.25 Bbls.
10:40 A.M.		2.08 Bbls.
11:40 A.M.		1.67 "
12:40 P.M.		1.25 "

Putting on Production

(1" = 1.67 Bbls.)

RECEIVED
STATE CORPORATION COMMISSION
JUL 27 1961
CONSERVATION DIVISION
Wichita, Kansas

P

W E L L R E C O R D

LEASE NAME L. Koehn WELL NO. 1 ELEVATION _____

LOCATION N¹/₄ NW¹/₄ NE¹/₄ Section 13-20S-2W, McPherson County, Kansas

WORK COMMENCED September 27, 1954 DRILLING COMMENCED September 27, 1954

DRILLING COMPLETED October 7, 1954

DRILLING CONTRACTOR J. A. Molland, 1111 North Main Street, Hutchinson, Kansas

ROTARY DRILLING FROM 0' TO 2986'

FORMATION FROM TO REMARKS

Shale & sand	0	40	
Shale, sand, shells	40	152	Set and cemented 3-5/8" OD 32# csg. at 152' w/ 125 sacks of cement add 1 sack of calcium chloride. Cement circulated.
Shale & shells	152	295	
Lime	295	490	
Lime & shale	490	645	
Sand & shale	645	720	
Lime	720	735	
Lime & shale	735	360	
Shale & lime	860	930	
Lime	930	975	
Shale & lime	975	1125	
Shale	1125	1620	
Lime	1620	1740	
Lime & shale	1740	1770	
Shale & lime	1770	1780	
Lime	1780	1880	
Lime & shale	1880	1900	
Shale & lime	1900	2035	
Lime & shale	2035	2080	
Shale	2080	2290	
Lime	2290	2425	
Lime & shale	2425	2540	
Shale & lime	2540	2625	
Lime & shale	2625	2690	
Shale & lime	2690	2745	
Shale & lime	2745	2793	
Lime & shale	2793	2865	
Shale & lime	2865	2925	
Chat	2925	2934	

RECEIVED
STATE CORPORATION COMMISSION
SEP 12 1961
CONSERVATION DIVISION
Wichita, Kansas

			Circulated for samples @ 2934' - 2 hrs and 2 min. Ran D.S.T. No. 1, open 60 min., gas to surface in 4 min., recovered 500' of free oil, FP-55#, FFP-135#, BHP-455# - 11 hrs. 1 min.
Cherty lime	2934	2960	Circulated for samples @ 2956' - 1 hr. and 12 min.
			Circulated for samples @ 2960' - 13 min
Chat	2960	2986	Circulated for samples @ 2960' - 56 min Circulated for samples @ 2970' - 56 min Circulated for samples @ 2975' - 41 min Ran D.S.T. No. 2, open 30 min., good blow and decreased, recovered 60' of oil cut mud, 270' of muddy oil and 870' of salt water, BHP-622# - 19 hrs. Set and cemented 5 1/2" OD casing at 2984' with 75 sacks of cement. Slope tests taken at regular intervals showed no deflections from the vertical.

2870

GLICKMAN OIL CO.
P. O. Box 3104
Washington St. Station
WICHITA 2, KANSAS