


STATE OF KANSAS
STATE CORPORATION COMMISSION

WELL PLUGGING RECORD

Give All Information Completely
Make Required Affidavit
Mail or Deliver Report to:
Conservation Division
State Corporation Commission
800 Bating Building
Wichita, Kansas

McPherson County, Sec. 13 Twp. 20S Rge. (E) 2 (W)

Location as "NE/CNW/SW" or footage from lines N/2 N/2 NE/4
Lease Owner Glickman Oil Company
Lease Name Lincoln Koehn Well No. 2
Office Address 703 S. St. Francis, Wichita, Kansas
Character of Well (completed as Oil, Gas or Dry Hole) Dry Hole
Date well completed November 29, 19 54
Application for plugging filed December 31, 19 54
Application for plugging approved 19
Plugging commenced November 29, 19 54
Plugging completed November 29, 19 54
Reason for abandonment of well or producing formation Dry Hole

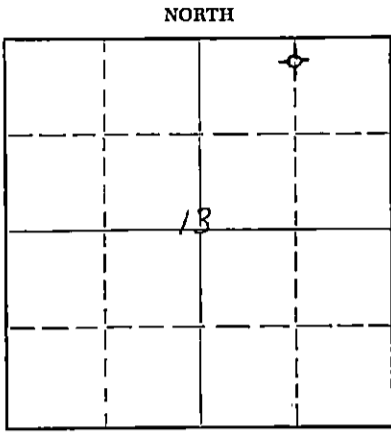

Locate well correctly on above Section Plat

If a producing well is abandoned, date of last production 19
Was permission obtained from the Conservation Division or its agents before plugging was commenced? Yes (Verbally)

Name of Conservation Agent who supervised plugging of this well Rael Durkee
Producing formation None Depth to top Bottom Total Depth of Well 2985 Feet
Show depth and thickness of all water, oil and gas formations.

OIL, GAS OR WATER RECORDS

CASING RECORD

FORMATION	CONTENT	FROM	TO	SIZE OD	PUT IN	PULLED OUT
Mississippi Lime	Dry	2938		8-5/8"	152	None

Describe in detail the manner in which the well was plugged, indicating where the mud fluid was placed and the method or methods used in introducing it into the hole. If cement or other plugs were used, state the character of same and depth placed, from feet to feet for each plug set.

Heavy Mud From 2985' to 150'
Wood Plug 150'
15 sacks of cement 150' to 120'
Heavy Mud 120' to 23'
Wood Plug 23'
5 sacks of cement 23' to 6'
Surface Soil 6' to 0'


(If additional description is necessary, use BACK of this sheet)
Name of Plugging Contractor J. A. Melland, Drilling Contractor
Address 1111 North Main Street, Hutchinson, Kansas

STATE OF Kansas, COUNTY OF Sedgwick, ss.
Wm. B. Glickman (employee of owner) or (owner or operator) of the above-described well, being first duly sworn on oath, says: That I have knowledge of the facts, statements, and matters herein contained and the log of the above-described well as filed and that the same are true and correct. So help me God.

(Signature) Wm. B. Glickman
P.O. Box 3108, Wichita, Kansas
(Address)

SUBSCRIBED AND SWORN TO before me this 8th day of January, 19 55

My commission expires Nov. 19, 1955
Lorella Bosley Notary Public.

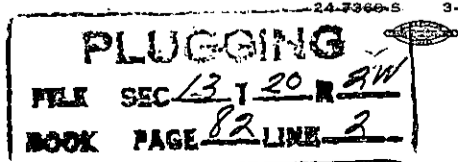

W E L L R E C O R D

LEASE NAME Lincoln Koehn WELL NO. 2 ELEVATION _____

LOCATION N/2 N/2 NE/4 of Section 13-20S-2W, McPherson County, Kansas

WORK COMMENCED November 20, 1954 DRILLING COMMENCED November 20, 1954

DRILLING COMPLETED November 29, 1954

DRILLING CONTRACTOR J. A. Molland, 1111 North Main St., Hutchinson, Kansas

LEASE OWNER Glickman Oil Company, Wichita, Kansas

ROTARY DRILLING FROM 0 TO 2985'

FORMATION	FROM	TO	REMARKS
Surface clay & shale	0	40	
Sand & shale	40	152	Set and cemented 8-5/8" OD 32# 10V thd., casing at 152' w/ 110 sacks of cement and 1 sack of calcium chloride. Cement circulated.
Shale & shells	152	340	
Lime	340	500	
Shale & lime	500	590	
Lime	590	625	
Shale	625	650	
Sand & shale	650	715	
Lime & shale	715	980	
Shale & lime	980	1135	
Shale	1135	1370	
Shells & shale	1370	1515	
Shale	1515	1625	
Shale & lime	1625	1805	
Lime & shale	1805	1850	
Shale & lime	1850	1890	
Lime	1890	1905	
Lime & shale	1905	2080	
Sand & shale	2080	2220	
Shale & shells	2220	2260	
Shale & lime shells	2260	2297	
Kansas City Lime	2297	2350	Circulated for samples @ 2305' - 30 min.
Lime & shale	2350	2510	
Shale & lime	2510	2590	
Shale	2590	2600	
Lime & shale	2600	2705	
Shale & lime	2705	2938	
Mississippi Lime	2938	2985	Circulated for samples @ 2940 - 1 hr. & 5 min. Circulated for samples @ 2951 - 1 hr. & 15 min. Circulated for samples @ 2969 - 1 hr. & 8 min. Circulated for samples @ 2968 - 53 min. Circulated for samples @ 2972 - 1 hr. Ran drill stem test from 2948 to 2972, open 1 hour, recovered 50' of oil cut mud, BHP-452# - 8 hrs. & 45 min. Circulated for samples @ 2976 - 1 hr. & 6 min. Circulated for samples @ 2985 - 45 min. Ran drill stem test from 2939 to 2968, open 1 hour, recovered 40' of drilling mud, BHP-312# - 8 hrs. & 26 min. As no oil or gas was encountered in commercial quantities, regular authority was granted to plug and abandon the well under directions of Ruel Durkee, S.C.C. Well Plugger as follows: Heavy mud from 2985' to 150', wood plug set at 150', 15 sacks of cement from 150' to 120', heavy mud from 120' to 23', wood plug set at 23', 5 sacks of cement from 23' to 6', surface soil from 6' to 0', plugged and abandoned 11/29/54. Slope tests taken at regular intervals showed no deflections from vertical.

RECORDED
INDEXED
JAN 11 1955
CONSERVATION DIVISION
WICHITA, KANSAS

PLUGGING
WELL SEC 13 20 R2W
E30N PAGE 62 LINE 2