


Give All Information Completely  
Make Required Affidavit  
Mail or Deliver Report to:  
Conservation Division  
State Corporation Commission  
800 Biting Building  
Wichita, Kansas

WELL PLUGGING RECORD

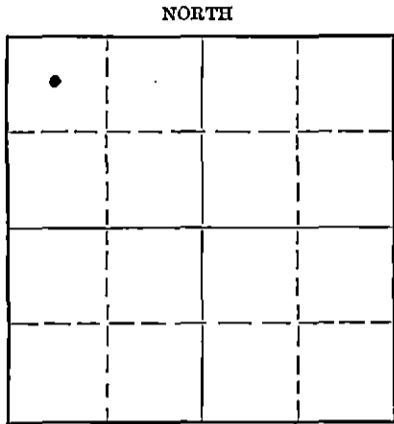

Locate well correctly on above Section Plat

MCPHERSON County. Sec. 13 Twp. 20 Rge. (E) 2 (W)  
Location as "NE/CNW $\frac{1}{4}$ SW $\frac{1}{4}$ " or footage from lines NWC NW  
Lease Owner CASEBEER & LITAN  
Lease Name KOEHN Well No. 1  
Office Address BOX 91, MCPHERSON, KANSAS  
Character of Well (completed as Oil, Gas or Dry Hole) GAS  
Date well completed 11/20 1944  
Application for plugging filed 4/9 1951  
Application for plugging approved 4/11 1951  
Plugging commenced 4/17 1951  
Plugging completed 4/23 1951  
Reason for abandonment of well or producing formation NON-COMMERCIAL  
If a producing well is abandoned, date of last production 19  
Was permission obtained from the Conservation Division or its agents before plugging was commenced? YES

Name of Conservation Agent who supervised plugging of this well RUEL DURKEE  
Producing formation CHAT Depth to top 2927 Bottom 2980 Total Depth of Well 2980 Feet  
Show depth and thickness of all water, oil and gas formations.

OIL, GAS OR WATER RECORDS

CASING RECORD

Formation	Content	From	To	Size	Put In	Pulled Out
SURFACE PIPE				8-5/8"	148'	NONE
CHAT	GAS	2937'	2980'	5 1/2"	3002	2322

Describe in detail the manner in which the well was plugged, indicating where the mud fluid was placed and the method or methods used in introducing it into the hole. If cement or other plugs were used, state the character of same and depth placed, from feet to feet for each plug set.

PUMPED 10 SAX OF CEMENT AT BOTTOM OF HOLE WITH HALLIBURTON. ~~SHOT PLUG~~ STOPPED AT 2385'. SHOT OFF PIPE AT 2322'. PULLED PIPE & MUDDING HOLE TO 145'. SET ROCK BRIDGE AND PUT 15 SAX OF CEMENT AT 145'. FINISHED MUDDING HOLE AND PUT 5 SAX OF CEMENT AT TOP OF SURFACE.

RECEIVED  
STATE CORPORATION COMMISSION  
MAY 3 - 1951  
CONSERVATION DIVISION  
Wichita, Kansas

(If additional description is necessary, use BACK of this sheet)  
Correspondence regarding this well should be addressed to DAVID LITAN  
Address BOX 91, MCPHERSON, KANSAS

STATE OF Kansas COUNTY OF McPherson, ss.  
DAVID LITAN (employee of owner) or (owner or operator) of the above-described well,  
being first duly sworn on oath, says: That I have knowledge of the facts, statements, and matters herein contained and the log of the above-described well as filed and that the same are true and correct. So help me God.  
(Signature) David Litau  
Box 91 - McPherson (Address)

SUBSCRIBED AND SWORN to before me this 2nd day of May, 1951  
J. L. Laskerford  
Notary Public.

PLUGGING  
FILE SEC 13 T 20 R 20  
BOOK PAGE 72 LINE 42


WELL LOG BUREAU KANSAS GEOLOGICAL SOCIETY  
412 Union National Bk. Bldg., Wichita, Kansas

Company P. G. REYNOLDS  
Farm Koehn No. 1

SEC. 13 T. 20 R. 2 W  
NWc NW

Total Depth. 2980'  
Comm. 11-4-44 Comp. 11-20-44  
Shot or Treated.  
Contractor. Veeder Sup. & Dev. Co.  
Issued. 3-2-46

County. McPherson  
KANSAS

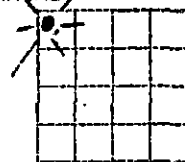

CASING:  
8 5/8" 148'  
5 1/2" 3002'

Elevation. \_\_\_\_\_

Production. Est. 1,380,000

Figures Indicate Bottom of Formations.

soil, clay, sand shale 0-145  
W.O.C.  
shale & shells 390  
lime - shale 620  
lime 890  
no log 960  
lime 1135  
shale & shells 1485  
lime 1715  
lime-shale 1765  
lime 1855  
lime & shale 1980  
lime 2120  
shale 2215  
lime 2927  
chats hrd 2929  
chats 2980  
Total Depth.

Tops:  
Kans. City 2228  
Mississippi 2927

HDST 2937-80, left open 30 min. showed gas in 15 min.  
Rec. 900' oil cut mud & 120' salt wtr.  
5 1/2" 2978 50 sax.

RUST, drilled cement 2966', Halliburton Steel Line equals 2965'  
(from top 5 1/2' cellar or 3' below Rot. Drive bushing) Lane Wells  
Measured 2973', Perf. 13/2968-72', rec. est. 2 B. salt wtr per  
hr. w/scum oil.

Set Lane Wells plug 2964'.

Perf. 7/2960-63', no results.  
" 12/2956-60', trace of oil, no oil  
" 11/2950-54', no results  
" 12/2940-46', definite inc. in gas.  
" 12/2936-42', no inc.

Est. 100,000 cu.ft. gas. Shut down.

Bailed hole down, set two hrs. & gauged 400,000 cu.ft. gas, 1/2 BWP est.  
Lane Wells plug 2947'. 1000 acid, gauged 700,000 cu.ft. gas. Shut in  
overnight & gauged 1,380,000 cu. ft. gas. No pressure taken. Shut in.

**PLUGGING**  
FILE SEC 13 T 20 R 2W  
BOOK PAGE 72 LINE 42

**RECEIVED**  
STATE CORPORATION COMMISSION  
APR 28 1951  
CONSERVATION DIVISION  
Wichita, Kansas

COMPANY- P.G. REYNOLDS  
FARM- KOEHN NO.1

15.113.02030.0000  
SEC. 13 T. 20 2W  
NWC NW

TOTAL DEPTH.-2980'  
COMM.- 11/4/44 COMP.- 11/20/44  
SHOT OR TREATED  
CONTRACTOR.-VEEDER SUP. & DEV. CO.  
ISSUED.- 3/2/46

COUNTY.-MCPHERSON, KANSAS

CASING:  
8-5/8" 148'  
5 1/2" 3002'

ELEVATION.....

PRODUCTION. EST. 1,380,000

FIGURES INDICATE BOTTOM OF FORMATIONS.

SOIL, CLAY, SAND SHALE	0-145
W.O.C.	
SHALE & SHELLS	390
LIME-SHALE	620
LIME	890
NO LOG	960
LIME	1135
SHALE & SHELLS	1485
LIME	1715
LIME-SHALE	1765
LIME	1855
LIME & SHALE	1980
LIME	2120
SHALE	2215
LIME	2927
CHATS HRD	2929
CHATS	2980
TOTAL DEPTH.	

TOPS:

KANS. CITY 2228  
MISSISSIPPI 2927

HDST 2937-80, LEFT OPEN 30 MIN. SHOWED GAS IN 15 MIN.  
REC. 900' OIL CUT MUD & 120' SALT WTR.  
5 1/2" 2978 50 SAX.

RUST, DRILLED CEMENT 2966', HALLIBURTON STEEL LINE EQUALS 2965'  
(FROM TOP 5 1/2' CELLAR OR 3' BELOW ROT. DRIVE BUSHING) LANE WELLS  
MEASURED 2973', PERF. 13/2968-72', REC. EST. 2 B. SALT WTR. PER  
HR. W/SCUM OIL.

SET LANE WELLS PLUG 2964'.

PERF. 7/2960-63', NO RESULTS.  
" 12/2956-60', TRACE OF OIL, NO OIL  
" 11/2950-54', NO RESULTS  
" 12/2940-46', DEFINITE INC. IN GAS.  
" 12/2936-42', NO INC.

EST. 100,000 CU. FT. GAS. SHUT DOWN

BAILED HOLE DOWN, SET TWO HRS. & GAUGED 400,000 CU. FT. GAS, 1/2 BWPH EST.  
LANE WELLS PLUG 2947'. 1000 ACID, GAUGED 700,000 CU. FT. GAS. SHUT IN  
OVERNIGHT & GAUGED 1,380,000 CU. FT. GAS. NO PRESSURE TAKEN. SHUT IN.

**PLUGGING**  
FILE SEC. 13 T. 20 R. 2W  
BOOK PAGE 7X LINE 42

RECEIVED  
STATE CORPORATION  
MAY 3 1951  
CONDENSED