


STATE OF KANSAS
STATE CORPORATION COMMISSION

Give All Information Completely
Make Required Affidavit
Mail or Deliver Report to:
Conservation Division
State Corporation Commission
800 Bitting Building
Wichita, Kansas

WELL PLUGGING RECORD

NORTH

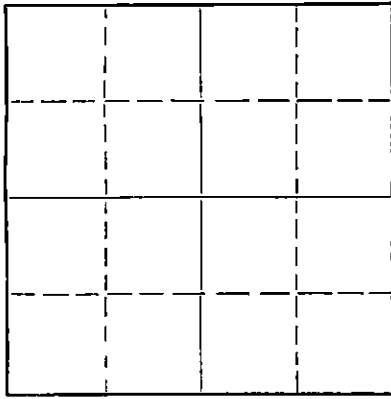

Locate well correctly on above
Section Plat

McPherson County. Sec. 4 Twp 20S Rge. 4W (E) (W)
Location as "NE/CNW/SW" or footage from lines SW SW SE
Lease Owner Anschutz Drilling Company, Inc.
Lease Name Sifts Well No. 1
Office Address 709 Union Nat'l Bk Bldg., Wichita, Kansas
Character of Well (completed as Oil, Gas or Dry Hole) Dry Hole
Date well completed 9-22, 19 52
Application for plugging filed 9-22, 19 52
Application for plugging approved 9-22, 19 52
Plugging commenced 9-22, 19 52
Plugging completed 9-22, 19 52
Reason for abandonment of well or producing formation Dry

If a producing well is abandoned, date of last production 19
Was permission obtained from the Conservation Division or its agents before plugging was commenced? Yes

Name of Conservation Agent who supervised plugging of this well Ruel Durkee
Producing formation Depth to top Bottom Total Depth of Well 3905 Feet
Show depth and thickness of all water, oil and gas formations.

OIL, GAS OR WATER RECORDS

CASING RECORD

FORMATION	CONTENT	FROM	TO	SIZE	PUT IN	PULLED OUT
				8-5/8"	250'	

Describe in detail the manner in which the well was plugged, indicating where the mud fluid was placed and the method or methods used in introducing it into the hole. If cement or other plugs were used, state the character of same and depth placed, from feet to feet for each plug set.

Top plug set at 15' with 5 sacks cement
Bottom plug set at 248' with 15 sacks cement

(If additional description is necessary, use BACK of this sheet)

Name of Plugging Contractor Flounoy-Haston Drilling Co., Inc.
Address Hoisington, Kansas

STATE OF KANSAS, COUNTY OF SEDGWICK, ss.
Leon L. Mehler (employee of owner) or (owner or operator) of the above-described well, being first duly sworn on oath, says: That I have knowledge of the facts, statements, and matters herein contained and the log of the above-described well as filed and that the same are true and correct. So help me God.

(Signature) Leon L. Mehler
709 Union Nat'l Bk Bldg., Wichita, Ks.
(Address)

SUBSCRIBED AND SWORN TO before me this 29th day of September, 19 52

My commission expires May 2, 1956

24-2675-S 2-52-20M

RECEIVED
CORPORATION COMMISSION

SEP 30 1952

PLUGGING
FILE SEC 4 T 20 R 42
BOOK PAGE 46 LINE 36

Notary Public.

9-30-1952

DRILLER'S LOG

Anschutz Drilling Company, Inc.
and
Pack Oil Company, Inc.
#1 Sitts
SW SW SE - 4-20S-4W
McPherson County, Kansas

<u>FROM</u>	<u>TO</u>	
0	305	Sand & shale
305	740	Shale & shells
740	1260	Lime & shale
1260	2090	Shale & shells
2090	2210	Lime, broken
2210	2635	Lime
2635	2675	Lime, broken
2675	2770	Sandy lime
2770	2815	Lime
2815	2835	Lime, broken
2835	3015	Lime
3015	3095	Lime & shale
3095	3145	Lime, broken
3145	3245	Lime & shale
3245	3302	Chert
3302	3392	Lime & chert
3392	3405	Chert
3405	3455	Lime & chert
3455	3478	Lime
3478	3500	Lime & chert
3500	3590	Lime & shale
3590	3637	Lime, shale & chert
3637	3793	Lime & shale
3793	3830	Viola lime
3830	3850	Sand
3850	3863	Sand & shale
3863	3890	Sand & lime
3890	3905	Lime
	3905	TOTAL DEPTH
		D&A

COMMENCED: 9-6-52
COMPLETED: 9-22-52

CASING RECORD

Set 8-5/8" surface casing at
250 feet with 100 sacks
cement.

ELEVATION: 1487 RB

TOPS

Lansing 2593
Mississippi 3245
Kinderhook 3524
Viola 3790
Simpson shale 3811
Simpson sand 3816
Arbuckle 3865

STATE OF KANSAS)
) SS
COUNTY OF SEDGWICK)

I hereby affirm that the above and foregoing is a true and correct copy of the log on the #1 Sitts located SW SW SE of Section 4-20S-4W, McPherson County, Kansas.

ANSCHUTZ DRILLING COMPANY, INC.

BY: *Leon L. Mehler*
Leon L. Mehler.

Subscribed and sworn to before me this 29th day of September, 1952.

Jacqueline Kennard
Notary Public

My commission expires: May 2, 1956

PLUGGING
FILE SEC 4 T20 R 42
BOOK PAGE 46 LINE 56

RECEIVED
CORPORATION COMMISSION
SEP 30 1952
CONSERVATION DIVISION
Wichita, Kansas