


STATE OF KANSAS
STATE CORPORATION COMMISSION

Give All Information Completely
Make Required Affidavit
Mail or Deliver Report to:
Conservation Division
State Corporation Commission
211 No. Broadway
Wichita, Kansas

15.113.00496.0000
WELL PLUGGING RECORD

NORTH

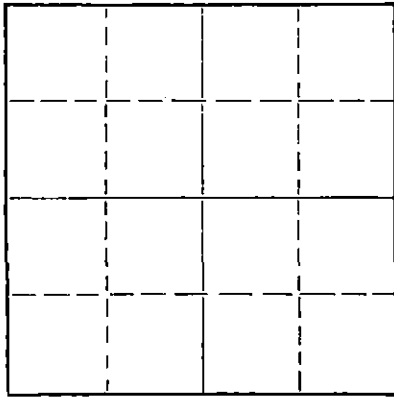

Locate well correctly on above
Section Plat

McPherson County, Sec. 6 Twp. 20 Rge. (E) 5 (W)
Location as "NE/CNW/SW" or footage from lines SE SW NW
Lease Owner Sterling Drilling Company, et al
Lease Name Barnes Well No. 1
Office Address Sterling, Kansas
Character of Well (completed as Oil, Gas or Dry Hole) Dry Hole
Date well completed August 6, 19 56
Application for plugging filed August 6, 19 56
Application for plugging approved August 6, 19 56
Plugging commenced August 6, 19 56
Plugging completed August 6, 19 56
Reason for abandonment of well or producing formation

If a producing well is abandoned, date of last production 19
Was permission obtained from the Conservation Division or its agents before plugging was commenced? Yes

Name of Conservation Agent who supervised plugging of this well R. M. Brundege
Producing formation Depth to top Bottom Total Depth of Well 3485 Feet
Show depth and thickness of all water, oil and gas formations.

OIL, GAS OR WATER RECORDS

CASING RECORD

FORMATION	CONTENT	FROM	TO	SIZE	PUT IN	PULLED OUT
				8-5/8"	200'	

Describe in detail the manner in which the well was plugged, indicating where the mud fluid was placed and the method or methods used in introducing it into the hole. If cement or other plugs were used, state the character of same and depth placed, from feet to feet for each plug set.

Filled hole with heavy mud. Set plug at 200' with 20 sacks cement.
Filled to 140' and set plug with 10 sacks cement. Circulated to surface.

(If additional description is necessary, use BACK of this sheet)

Name of Plugging Contractor Sterling Drilling Company
Address Sterling, Kansas

STATE OF KANSAS, COUNTY OF RICE, ss.
F. A. Whellner (employee of owner) or (owner or operator) of the above-described well, being first duly sworn on oath, says: That I have knowledge of the facts, statements, and matters herein contained and the log of the above-described well as filed and that the same are true and correct. So help me God.

(Signature) *F. A. Whellner*

Sterling, Kansas
(Address)

SUBSCRIBED AND SWORN TO before me this 7th day of August, 19 56

My Commission Expires Jan. 22, 1958

Bernard Lauderbach
RECEIVED
STATE CORPORATION COMMISSION

Notary Public.

My commission expires

PLUGGING
FILE SEC. 6 T. 20 R. 5W
BOOK PAGE 88 LINE 6

AUG 3 1956
CONSERVATION DIVISION
Wichita, Kansas

STERLING DRILLING COMPANY
Sterling, Kansas

WELL LOG ----- BANNIS #1

Located: SE SW NW 6-20S-5W, McPherson County, Kansas

OWNER: STERLING DRILLING COMPANY, et al
ROTARY DRILLING CONTRACT: STERLING DRILLING COMPANY

DATE COMMENCED: 7-27-56

DATE COMPLETED: 8-6-56

3485: TOTAL DEPTH

LOG

0 - 208	Red Bed & Shale	Run 200: 8-5/8 set w/135
208 - 550	Shale	sax and 2 sax c.c.
550 - 2335	Lime & Shale	
2335 - 2565	Lime	
2565 - 2725	Lime & Shale	
2725 - 3150	Lime	
3150 - 3270	Lime & Shale	<u>Production</u>
3270 - 3366	Lime	
3366 - 3485	Conglomerate T D	Plugged & Abandoned

PLUGGING			
FILE	SEC	T	R
	6	20	5W
BOOK	PAGE	LINE	
	88	6	

RECEIVED
STATE CORPORATION COMMISSION

AUG 3 1956

CONSERVATION DIVISION
Wichita, Kansas