


WELL PLUGGING RECORD

Give All Information Completely
Make Required Affidavit
Mail or Deliver Report to:
Conservation Division
State Corporation Commission
800 Biting Building
Wichita, Kansas

Mc Pherson County, Sec. 1 Twp. 20 Rge. 5 (E) (W)
Location as "NE/CNW $\frac{1}{4}$ SW $\frac{1}{4}$ " or footage from lines SW, SW, SE.
Lease Owner Continental Oil Co.
Lease Name J.M. Stutzman Well No.
Office Address Drawer 1267, Ponca City, Okla.
Character of Well (completed as Oil, Gas or Dry Hole) Dry
Date well completed 2-20-51 19
Application for plugging filed 2-22-51 19
Application for plugging approved 2-22-51 19
Plugging commenced 2-22-51 19
Plugging completed 2-22-51 19
Reason for abandonment of well or producing formation dry
If a producing well is abandoned, date of last production none 19
Was permission obtained from the Conservation Division or its agents before plugging was commenced? Yes

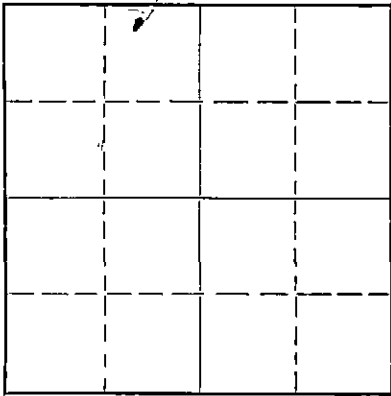

Locate well correctly on above Section Plat

Name of Conservation Agent who supervised plugging of this well Mr. Ruel Durkee
Producing formation none Depth to top Bottom Total Depth of Well 3474 Feet
Show depth and thickness of all water, oil and gas formations.

OIL, GAS OR WATER RECORDS

CASING RECORD

Formation	Content	From	To	Size	Put In	Pulled Out
		0	200	75/8	200'	None

Describe in detail the manner in which the well was plugged, indicating where the mud fluid was placed and the method or methods used in introducing it into the hole. If cement or other plugs were used, state the character of same and depth placed, from...feet to...feet for each plug set.
Gunned pits and circulated heavy mud at 1700'. Put 2 Halliburton plug and sack of hull to 190' and ran 15 sack of cement at 190'. Put one plug and sack of hull at 20' and ran 5 sacks of cement at 20' to surface.

MAR - 1 1951
CONSERVATION DIVISION
Wichita, Kansas

(If additional description is necessary, use BACK of this sheet)
Correspondence regarding this well should be addressed to Jack J. Cowden
Address Box 443, Lyons, Kansas

STATE OF KANSAS, COUNTY OF SEDGWICK, ss.
Jack J. Cowden (employee of owner) or (owner or operator) of the above-described well,
being first duly sworn on oath, says: That I have knowledge of the facts, statements, and matters herein contained and the log of the above-described well as filed and that the same are true and correct. So help me God.

(Signature) Jack J. Cowden
Box 443 Lyons, Kansas (Address)

SUBSCRIBED AND SWORN to before me this 28th day of February, 1951
Pauline Arnett
Notary Public.

My commission expires Feb. 26, 1955

PLUGGING
FILE SEC-1 T-20 R-512
BOOK PAGE 65107-6

WELL LOG

Continental Oil Co.
 J. A. Stutzman No. 1, Sec 1-208-5W, SW SW SE
 McPherson County, Kansas - Strat AA-115
 Elevation - 1561 DF

Shale	206
Shale, anhydrite	572
Salt	633
Shale, salt	724
Shale, anhydrite	1149
Lime	1298
Shale	1527
Shale, lime	2341
Lime	2354
Lime, shale	2359
Lime	2537
Lime, shale	2550
Lime	2652
Lime, shale	2675
Lime	2698
Shale, lime	2725
Shale	2738
Shale, lime	2747
Lime	2761
Shale	2770
Lime	2797
Shale	2800
Lime	2813
Lime, shale	2848
Lime	2951
Lime, shale	3005
Lime	3039
Lime, shale	3052
Lime	3058
Shale	3062
Lime	3078
Lime, shale	3085
Lime	3089
Lime, shale	3093
Lime	3101
Lime, shale	3105
Lime	3146
Shale, Lime	3197
Shale	3209
Lime, Shale	3212
Lime	3226
Shale	3229
Lime	3239
Shale	3241
Lime	3244
Shale	3247
Lime, shale	3296
Shale, Butt	3359
Shale	3396
Lime	3411
Lime, shale	3434
Lime, chert	3474
Total Depth	3474

Casing: 7 5/8" at 207'

Tops: Heebner	2516	(-955)
Lansing	2740	(-1179)
Miss.	3394	(-1833)

Spud: 2-6-51
 Completed: 2-24-51

Ran Laterolog and Gamma Ray

D&A

