


Give All Information Completely
Make Required Affidavit
Mail or Deliver Part to:
Conservation Division
State Corporation Commission
800 Bittling Building
Wichita, Kansas

WELL PLUGGING RECORD

NORTH

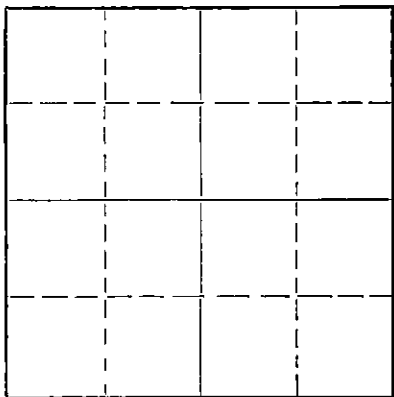

Locate well correctly on above
Section Plat

McPherson

County. Sec. 27 Twp. 20 Rge. 4 (E) (W)

Location as "NE/CNW/SW" or footage from lines SW SW SE

Lease Owner Anschutz Drilling Company, Inc.

Lease Name Mitchell

Well No. 1

Office Address Union Nat'l Bk Bldg., Wichita, Ks.

Character of Well (completed as Oil, Gas or Dry Hole) Lost circulation

Date well completed 9-26 1952

Application for plugging filed 9-26 1952

Application for plugging approved 9-26 1952

Plugging commenced 9-26 1952

Plugging completed 9-26 1952

Reason for abandonment of well or producing formation Lost circulation

If a producing well is abandoned, date of last production 19

Was permission obtained from the Conservation Division or its agents before plugging was commenced? Yes

Name of Conservation Agent who supervised plugging of this well Ruel Durkee

Producing formation Depth to top Bottom Total Depth of Well 648 Feet

Show depth and thickness of all water, oil and gas formations.

OIL, GAS OR WATER RECORDS

CASING RECORD

FORMATION	CONTENT	FROM	TO	SIZE	PUT IN	PULLED OUT
				8-5/8"	300'	

Describe in detail the manner in which the well was plugged, indicating where the mud fluid was placed and the method or methods used in introducing it into the hole. If cement or other plugs were used, state the character of same and depth placed, from feet to feet for each plug set.

Top plug set at 15' with 5 sacks cement

Bottom plug set at 250' with 25 sacks cement

(If additional description is necessary, use BACK of this sheet)

Name of Plugging Contractor Flournoy-Haston Drilling Co., Inc.

Address Great Bend, Kansas

STATE OF KANSAS, COUNTY OF SEDGWICK, ss.

Leon L. Mehler

(employee of owner) or (owner or operator) of the above-described

well, being first duly sworn on oath, says: That I have knowledge of the facts, statements, and matters herein contained and the log of the above-described well as filed and that the same are true and correct. So help me God.

(Signature)

Leon L. Mehler

709 Union Nat'l Bk Bldg., Wichita, Ks.

(Address)

SUBSCRIBED AND SWORN TO before me this 2nd day of October, 1952

My commission expires May 2, 1956

24-2675-5

2-52-20M

Notary Public.


RECEIVED
OCT - 7 1952
CONSERVATION DIVISION
Wichita, Kansas

10-4-1952

DRILLER'S LOG

Anschutz Drilling Company, Inc.
and
Pack Oil Company, Inc.
#1 Mitchell
SW SW SE - 27-20S-4W
McPherson County, Kansas

FROM TO

0 315 Clay
315 430 Sand & shells
430 648 Shale & shells
648 TOTAL DEPTH
Well Abandoned
Lost Circulation

COMMENCED: 9-23-52
COMPLETED: 9-27-52

CASING RECORD

Set 8-5/8" surface casing at 300'
with 150 sacks cement.

STATE OF KANSAS
COUNTY OF SEDGWICK

)
) SS
)

I hereby affirm that the above and foregoing is a true and correct copy of the log on the #1 Mitchell, SW SW SE 27-20S-4W, McPherson County, Kansas.


ANSCHUTZ DRILLING COMPANY, INC.

BY: *Leon L. Mehler*
Leon L. Mehler

Subscribed and sworn to before me this 29th day of October, 1952

Jacqueline Kinsman
Notary Public

My Commission Expires: May 2, 1956

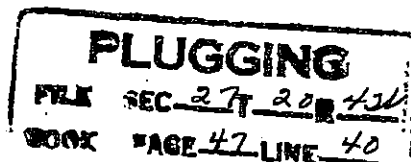

RECEIVED
STATE CONSERVATION COMMISSION
NOV - 4 1952
CONSERVATION DIVISION
Wichita, Kansas