


15.113.21041.0000

WELL PLUGGING RECORD

Give All Information Completely  
 Make Required Affidavit

COUNTY McPherson SEC. 25 TWP. 20 SRGE. 4  W  
 Location as in quarters or footage from lines:  
C SE NW 1980' FN & WL of Section

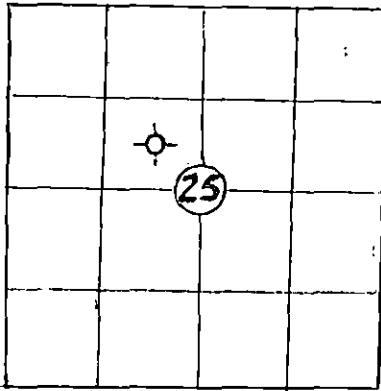

Locate Well  
 correctly on above  
 Section Platt.

Lease Owner R. J. Walker Oil Co., Inc.  
 Lease Name G. Baerg Well No. 1-25  
 Office Address 3524 N.W. 56th St. Okla. City, Okla. 73112  
 Character of Well (Completed as Oil, Gas or Dry Hole): Dry Hole (c)  
 Date Well Completed 3-7-83 (L)  
 Application for plugging filed 3-7-83  
 Plugging commenced 3-7-83  
 Plugging completed 3-7-83  
 Reason for abandonment of well or producing formation D & A

Was permission obtained from the Conservation Division or it's  
 Agent's before plugging was commenced? Yes

Name of Conservation Agent who supervised plugging of this well Merlin Unruh  
 Producing formation none Depth to top            bottom T.D. 3900'  
 Show depth and thickness of all water, oil and gas formations.

OIL, GAS OR WATER RECORDS

Casing Record

| Formation | Content | From | To | Size   | Put in | Pulled Out |
|-----------|---------|------|----|--------|--------|------------|
|           |         |      |    | 13 3/8 | 225'   | -0-        |
|           |         |      |    | 8 5/8  | 664'   | -0-        |
|           |         |      |    |        |        |            |
|           |         |      |    |        |        |            |

Describe in detail the manner in which the well was plugged, indicating where the mud  
 fluid was placed and the method or methods used in introducing it into the hold. If cement  
 or other plugs were used, state the character of same and depth placed, from            feet  
 to            feet for each plug set.

- 40 sax Class A Common @ 810' w/pump truck through D.P.
- 25 sax Class A Common @ 275' w/pump truck through D.P.
- 1/2 sax hulls, plug @ 35' w/pump truck to surface
- 10 sax Common in RH & 10 sax Common in MH through D.P.

(If additional description is necessary, use BACK of this sheet)

Name of Plugging Contractor Kansas Drilling & Well Service, Inc.

STATE OF Oklahoma COUNTY OF Oklahoma, ss.  
OSCAR GOODR (employee of owner) or (owner or operator) of the  
 above-described well, being first duly sworn on oath, says: That I have knowledge of the  
 facts, statements, and matters herein contained and the log of the above-described well as  
 filed and that the same are true and correct. So help me God.

(Signature) *Oscar Goodr*  
57150 - 3524 NW 56th St., OKC, OK 73112  
 (Address)

SUBSCRIBED AND SWORN TO before me this 17th day of March 19 83

*Dana J. Raley*  
 Notary Public.  
 STATE CORPORATION COMMISSION

My Commission expires 12-31-83

MAR 21 1983