


STATE OF KANSAS
STATE CORPORATION COMMISSION

Form CP-4

Give All Information Completely
Make Required Affidavit
Mail or Deliver Report to:
Conservation Division
State Corporation Commission
212 No. Market
Wichita, Kansas 67202

WELL PLUGGING RECORD

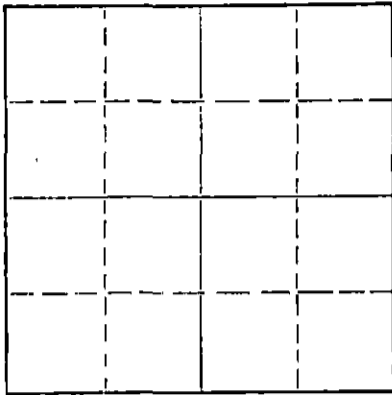

Locate well correctly on above
Section Plat

Rice County, Sec. 5 Twp. 21 Rge. 6 W (E) (W)
Location as "NE/CNW/SW" or footage from lines NW SW SW
Lease Owner Pat Simmons
Lease Name Renollet Well No. 2
Office Address 5252 North Broadway, Wichita, Kansas 67219
Character of Well (completed as Oil, Gas or Dry Hole) oil
Date well completed 7-10 19 50
Application for plugging filed 5-30 19 70
Application for plugging approved 6-1 19 70
Plugging commenced 6-2 19 70
Plugging completed 6-4 19 70
Reason for abandonment of well or producing formation _____

If a producing well is abandoned, date of last production _____ 19____
Was permission obtained from the Conservation Division or its agents before plugging was commenced? Yes

Name of Conservation Agent who supervised plugging of this well Hugh Scott Gilbert Tamen
Producing formation _____ Depth to top _____ Bottom _____ Total Depth of Well 3533' Feet
Show depth and thickness of all water, oil and gas formations.

OIL, GAS OR WATER RECORDS

CASING RECORD

FORMATION	CONTENT	FROM	TO	SIZE	PUT IN	PULLED OUT
				<u>5 1/2</u>		<u>2,506'</u>
RECEIVED STATE CORPORATION COMMISSION JUN 10 1970 CONSERVATION DIVISION Wichita, Kansas						

Describe in detail the manner in which the well was plugged, indicating where the mud fluid was placed and the method or methods used in introducing it into the hole. If cement or other plugs were used, state the character of same and depth placed, from _____ feet to _____ feet for each plug set.

Plugged off bottom of hole with sand. Sand from 3533' to 3475'. Dumped 5 sz of cement. Mudded hole to 210'. Made 10' of rock bridge. Dumped 35 sz of cement. Mudded hole to 40'. Made 10' of rock bridge. Dumped 10 sz of cement, filling to the bottom of the collar.

(If additional description is necessary, use BACK of this sheet)

Name of Plugging Contractor Art Lamb Casing Pulling Co.
Address 2809 King St. Hutchinson, Kansas 67501

STATE OF Kansas, COUNTY OF Reno, ss.
Art Lamb (employee of owner) or (owner or operator) of the above-described well, being first duly sworn on oath, says: That I have knowledge of the facts, statements, and matters herein contained and the log of the above-described well as filed and that the same are true and correct. So help me God.

(Signature) [Signature]
2809 King St. Hutchinson, Kansas 67501
(Address)

SUBSCRIBED AND SWORN to before me this 4th day of June, 19 70

My commission expires January 5, 1974

[Signature]
Notary Public.

WELL LOG BUREAU -- KANSAS GEOLOGICAL SOCIETY
508 E. Murdock, Wichita, Kansas

COPY

15.159.03826.0000

Company - H. C. BENNETT
Farm - Henollet No. 2

SEC. 5 T. 21 R. 6W
NW SW SW
1320' FSL, 480' FWL

Total Depth. 3533
Comm. 6-26-50 Comp. 7-10-50
Shot or T. tested.
Contractor.
Issued. 9-23-50

County. Rice
KANSAS



Elevation. 1682

Production. dry

CASING:

8 5/8" 140' cem w/140 sx. R.P.
5 1/2" 3490 1/2' cem w/50 sx. R. B.

Figures Indicate Bottom of Formations.

sand	80
redbed, shale	290
shale	435
shale, shells	780
shale, salt	900
shale, shells	980
lime, shale	1015
anhydrite	1065
lime, shale	1850
shale, shells	2060
lime, shale	2605
lime	2740
lime, shale	2975
lime	3255
lime, shale	3331
lime	3450
lime, shale	3480
cong.	3490
chat	3493
Drilled deeper	
3504, SSO & Water	
chat? SSO & WTR	3533
Total depth	
Tops: Scout	
Mississippi	3487

RECEIVED
STATE CORPORATION COMMISSION
JUN 1 1970
CONSERVATION DIVISION
Wichita, Kansas