


WELL PLUGGING RECORD

Give All Information Completely
Make Required Affidavit
Mail or Deliver Report to:
Conservation Division
State Corporation Commission
800 Westing Building
Wichita, Kansas

NORTH

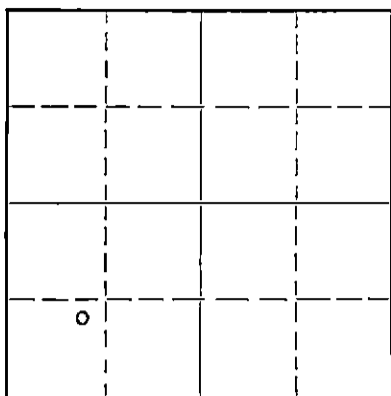

Locate well correctly on above Section Plat

Rice County. Sec. 5 Twp. 21S Rge. 6W (W)
Location as "NE/CNW $\frac{1}{4}$ SW $\frac{1}{4}$ " or footage from lines NW SW SW
Lease Owner H. C. Bennett
Lease Name Renollet Well No. 2
Office Address P. O. Box 31, Augusta, Kansas
Character of Well (completed as Oil, Gas or Dry Hole) Dry Hole
Date well completed August 24, 1950 19
Application for plugging filed August 24, 1950 19
Application for plugging approved August 24, 1950 19
Plugging commenced August 24, 1950 19
Plugging completed August 28, 1950 19
Reason for abandonment of well or producing formation Dry Hole

If a producing well is abandoned, date of last production none 19
Was permission obtained from the Conservation Division or its agents before plugging was commenced? Yes

Name of Conservation Agent who supervised plugging of this well C. D. Stough
Producing formation Depth to top Bottom Total Depth of Well 3532 Feet
Show depth and thickness of all water, oil and gas formations.

OIL, GAS OR WATER RECORDS

CASING RECORD

Formation	Content	From	To	Size	Put In	Pulled Out
				8 5/8"	110	
				5 1/2"	3490	3142'

Describe in detail the manner in which the well was plugged, indicating where the mud fluid was placed and the method or methods used in introducing it into the hole. If cement or other plugs were used, state the character of same and depth placed, from feet to feet for each plug set.

110 feet of 8 5/8" surface pipe circulated with cement. 5 1/2" casing set at 3490 feet. Plugged back to 3480 feet with chat, 5 sacks of cement with dump bailer at 3480 feet. Shot off and pulled the 5 1/2" casing. Filled with mud to 165 feet. Set rock bridge and 15 sacks of cement at 165 feet. Mud to 35 feet. Bridge and 10 sacks of cement at the surface.
Plugging Contractor: R & L Pipe Pulling Company

(If additional description is necessary, use BACK of this sheet)

Correspondence regarding this well should be addressed to H. C. Bennett,
Address P. O. Box 31,
Augusta, Kansas

STATE OF _____, COUNTY OF _____, ss.
(employee of owner) or (owner or operator) of the above-described well,
being first duly sworn on oath, says: That I have knowledge of the facts, statements, and matters herein contained and the log of the above-described well as filed and that the same are true and correct. So help me God.

(Signature) *H. C. Bennett*
Box 31 Augusta, Kansas
Sept 27 1950
Seward A. Green
Notary Public.

SUBSCRIBED AND SWORN to before me this 27th day of Sept 1950

My commission expires Jan. 31, 1953

22-7377-s 4-49-10M

RECEIVED
STATE CORPORATION COMMISSION

SEP 28 1950

CONSERVATION DIVISION
Wichita, Kansas

PLUGGING
FILE REC 5 T 21 R (60)
BOOK PAGE 23 LINE 18

H. G. Bennett
Revollet # 2

Sec. 5 Twp 21S Rge 6W
Rice County, Kansas

Total Depth: 3493'
Comm: 6-26-50
Comp: 7-10-50

Tops: Miss. Chat 3490'
Conglomerate Chert 3485-3488'

Casing
8 5/8" Set @ 140'
5 1/2" Set @ 3490 1/2'

Cement
140 Sacks of Victor
50 sacks of Altas

Formation	Depth:
Sand	80
Red Bed-Shale	290
Shale	435
Shale-Shells	780
Shale-Salt	900
Shale-Shells	980
Shale-Lime	1015
Anhydrite	1065
Shale-Lime	1850
Shale-Shells	2060
Shale-Lime	2605
Lime	2740
Lime-Shale	2975
Lime	3255
Lime-Shale	3331
Lime	3450
Lime-Shale	3480
Conglomerate	3490
Chat	3493'

STATE OF KANSAS)
)SS
RUSSELL COUNTY)

Drilled in with Cable Tools
slight show of oil at 3515' to -20'
Drilled to total depth of 3532'
with no increase of oil

I hereby certify that the above information is true and correct to the best of my knowledge.

Violet Feller

Subscribed and sworn to before me this 18th day of July, 1950.

Wm. L. ...
Notary Public

My commission expires: 6-17-54 1

Plugging Record

Filled with crushed rock 3532 to 3480
Dumped 5 sacks cement.
5 1/2" casing recovered 3142'
Mudded hole to 165', 10' rock bridges
75 sacks cement.
Mud to 30' rock bridge and 10 sacks cement.
Completed 8-28-50.

