


WELL PLUGGING RECORD

Give All Information Completely
Make Required Affidavit
Mail or Deliver Report to:
Conservation Division
State Corporation Commission
800 Biting Building
Wichita, Kansas

Rice County. Sec. 35 Twp. 21 Rge. 6 (E) (W)

Location as "NE/CNW/SW" or footage from lines NW NW NE
Lease Owner Dozier Oil Company
Lease Name Renollet Well No. 1
Office Address Union National Bank Building, Wichita, Ks.
Character of Well (completed as Oil, Gas or Dry Hole) DRY HOLE
Date well completed 7-26-53 19
Application for plugging filed 7-26-53 19
Application for plugging approved 7-26-53 19
Plugging commenced 7-26-53 19
Plugging completed 7-26-53 19
Reason for abandonment of well or producing formation _____

NORTH

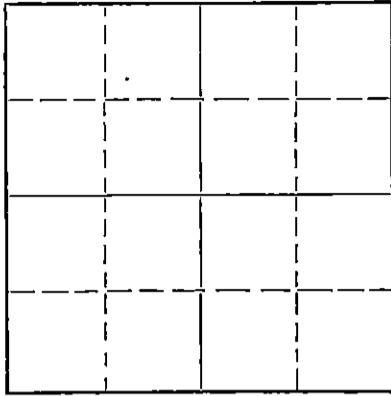

Locate well correctly on above
Section Plat

If a producing well is abandoned, date of last production _____ 19____
Was permission obtained from the Conservation Division or its agents before plugging was commenced? YES

Name of Conservation Agent who supervised plugging of this well Ruel Durkee
Producing formation _____ Depth to top _____ Bottom _____ Total Depth of Well 3490 Feet
Show depth and thickness of all water, oil and gas formations.

OIL, GAS OR WATER RECORDS

CASING RECORD

FORMATION	CONTENT	FROM	TO	SIZE	PUT IN	PULLED OUT
		0	137	8 5/8"		

Describe in detail the manner in which the well was plugged, indicating where the mud fluid was placed and the method or methods used in introducing it into the hole. If cement or other plugs were used, state the character of same and depth placed, from 137 feet to 30 feet for each plug set.

Used two Halliburton Plugs Pushed one Plug to the depth of 137 Feet cemented with 15-sacks cement through drill pipe. Push top plug to the depth of 30 Feet cemented with 10-sacks cement.

(If additional description is necessary, use BACK of this sheet)

Name of Plugging Contractor Stag Drilling Inc.
Address Box 169, Chase, Kansas.

STATE OF KANSAS Kansas, COUNTY OF Rice, ss.
C.L. Tyrrell (employee of owner) or (owner or operator) of the above-described well, being first duly sworn on oath, says: That I have knowledge of the facts, statements, and matters herein contained and the log of the above-described well as filed and that the same are true and correct. So help me God.

(Signature) C. L. Tyrrell
(Address) _____

SUBSCRIBED AND SWORN TO before me this 30th day of July, 19 53

Olando Miller
Notary Public.

My commission expires 3-1-55

24-7366-5 3-53-20M

PLUGGING
FILE SEC 57-21R-60
BOOK PAGE 117 LINE 40

RECEIVED
STATE CORPORATION COMMISSION
JUL 31 1953
CONSERVATION DIVISION
Wichita, Kansas

CONTRACTOR'S WELL LOG

OPERATOR Dozier Oil Co/ Farm Name RENOLLET Well No. 1
 LOCATION NW NW NE 25-21-6 COUNTY Rice STATE Kansas
 COMMENCEMENT DATE 7/14/53 COMPLETION DATE 7/26/53

Log of Well

From	To	Formation	Deviation from Vertical	Remarks
0	137	Surface Soil		
137	550	Shale-Shells		
550	850	Salt		
850	1015	Shale Shells		
1015	1155	Lime shale		
1155	1240	Sand Shale		
1240	1725	Lime shale		
1725	2175	Shale shells		
2175	2360	lime shale		
2360	2455	lime		
2455	2708	lime shale		
2708	2876	shale-lime(sandy)		
2876	3315	lime		
3315	3410	lime shale		
3410	3470	congl.		
3470	3490	Miss. Total Depth		dry hole

Set 137' (7 jts) 8 5/8" casing

STATE OF KANSAS)
 COUNTY OF RICE) SS

The undersigned certifies that to the best of his knowledge and belief the above facts are true and correct.

Stag Drilling Inc.,

By: C. J. Jynell
 President

Subscribed and sworn to before me this 29th day of July 1953

My Commission Expires 3/1/55

Orlando Miller
 Notary Public.

RECEIVED
 STATE CORPORATION COMMISSION
 AUG - 1 1953
 CONSERVATION DIVISION
 Wichita, Kansas

PLUGGING
 FILE SEC 21 R 6W
 BOOK PAGE 117 LINE 40