


STATE OF KANSAS  
STATE CORPORATION COMMISSION

Form CP-4

Give All Information Completely  
Make Required Affidavit  
Mail or Deliver Report to:  
Conservation Division  
State Corporation Commission  
212 No. Market  
Wichita, Kansas 67202

WELL PLUGGING RECORD

NORTH

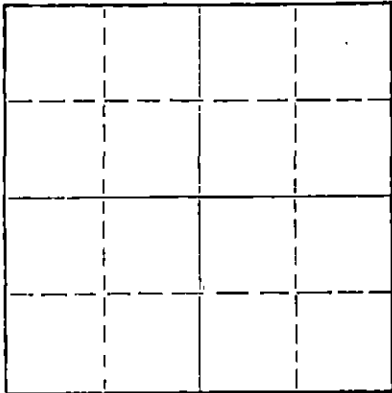

Locate well correctly on above  
Section Plat

Rice County. Sec. 5 Twp. 21 Rge. 6 W (E) (W)  
Location as "NE/CNWxSWx" or footage from lines 330'N/330'W/E/4 Cor  
Lease Owner F. G. Holl  
Lease Name Renollett Well No. I  
Office Address 6427 East Kellar, Wichita, Kansas  
Character of Well (completed as Oil, Gas or Dry Hole) oil  
Date well completed 4-15 19 48  
Application for plugging filed 7-7 19 70  
Application for plugging approved 7-8 19 70  
Plugging commenced 7-15 19 70  
Plugging completed 7-16 19 70  
Reason for abandonment of well or producing formation \_\_\_\_\_

If a producing well is abandoned, date of last production \_\_\_\_\_ 19\_\_\_\_  
Was permission obtained from the Conservation Division or its agents before plugging was commenced? Yes

Name of Conservation Agent who supervised plugging of this well Gilbert Toran  
Producing formation \_\_\_\_\_ Depth to top \_\_\_\_\_ Bottom \_\_\_\_\_ Total Depth of Well 3457' Feet  
Show depth and thickness of all water, oil and gas formations.

OIL, GAS OR WATER RECORDS

CASING RECORD

FORMATION	CONTENT	FROM	TO	SIZE	PUT IN	PULLED OUT
				5 1/2		481'

Describe in detail the manner in which the well was plugged, indicating where the mud fluid was placed and the method or methods used in introducing it into the hole. If cement or other plugs were used, state the character of same and depth placed, from \_\_\_\_\_ feet to \_\_\_\_\_ feet for each plug set.

Plugged off bottom of hole with sand. Sand from 3457' to 3430'. Dumped 5 sx of cement. Mudded hole to 240'. Made 10' of rock bridge. Dumped 25 sx of cement. Mudded hole to 40'. Made 10' of rock bridge. Dumped 10 sx of cement, filling to the bottom of the celler.

RECEIVED  
STATE CORPORATION COMMISSION  
JUL 20 1970  
CONSERVATION DIVISION  
Wichita, Kansas

(If additional description is necessary, use BACK of this sheet)

Name of Plugging Contractor Art Lamb Casing Pulling Co.  
Address 2809 King St. Hutchinson, Kansas 67501

STATE OF Kansas, COUNTY OF Leaw, ss.  
Art Lamb (employee of owner) or (owner or operator) of the above-described well, being first duly sworn on oath, says: That I have knowledge of the facts, statements, and matters herein contained and the log of the above-described well as filed and that the same are true and correct. So help me God.

(Signature) Art Lamb  
2809 King St. Hutchinson, Kansas (Address)

SUBSCRIBED AND SWORN to before me this 18th day of July, 19 70

My commission expires Jan 5, 1974  
Rudy Lamb Notary Public.

# WELL RECORD

Company Cities Service Oil Co. Well No. 1 Farm Nonollet  
 Location 330' North and 330' West of E/4 Corner Sec. 5 T. 21 R. 6W  
 Elevation 1642 (1640 Gr.) County Rice State Kansas  
 Drg. Comm. March 27, 1948 Contractor Herndon Drilling Company  
 Drg. Comp. April 15, 1948 Acid None  
 T. D. 3457' Initial Prod. Pumped 65 oil, trace water, 24 hrs. (4-29-48)

CASING RECORD:

8-5/8" @ 242' cem. 200 sx cem. and  
 200# C. C.  
 5-1/2" @ 3444' cem. 100 sx cem.

FORMATION RECORD:

sand	0-40
red rock	80
sand & red rock	242
shale & red bed	850
salt & shale	1035
shale & lime	1245
shale & shells	1580
lime	1635
shale & lime	1755
shale	2390
lime & shale	2455
shale & lime	2480
lime & shale	2495
lime	2515
lime & shale	2540
lime	2695
shale & lime	2815
lime	3410
lime & shale	3446
chert	3449
3449 Rot. TD = 3446 GEM	
chert	3457 T. D.

Corr. Top Lansing	2896'
Corr. Top Conglomerate	3405'
Corr. Top Mississippi	3443'
Penetration	14'
Total Depth	3457'

1642  
 1642  
 1642

Fillup:

1500' oil in 1 hr. 40 mins.  
 1860' oil in 2 hrs.  
 2575' oil in 2 hrs. 40 mins.  
 2900' oil in 3 hrs. 40 mins.  
 Hole full oil and made flow in 4 1/2 hrs.

SYFO:	250'	OK
	500'	OK
	750'	OK
	1000'	OK
	1250'	OK
	1500'	OK
	1750'	10
	2000'	20
	2250'	30
	2400'	40
	2442'	50
	2470'	60
	2500'	70
	2590'	80
	2650'	90
	2800'	100
	2930'	110
	3050'	120
	3200'	130
	3420'	140

RECEIVED  
 STATE CORPORATION COMMISSION  
 JUL 8 1970  
 CONSERVATION DIVISION  
 Wichita, Kansas

64  
 4 5/8