


WELL PLUGGING RECORD

Give All Information Completely
Make Required Affidavit
Mail or Deliver Report to:
Conservation Division
State Corporation Commission
800 Bittling Building
Wichita, Kansas

Rice County. Sec. 5 Twp. 21S Rge. 6W (b) (W)
Location as "NE/CNW $\frac{1}{4}$ /SW $\frac{1}{4}$ " or footage from lines NE NE SE
Lease Owner H. C. Bennett
Lease Name A. Engelland Well No. 3
Office Address P. O. Box 31, Augusta, Kansas
Character of Well (completed as Oil, Gas or Dry Hole) Dry Hole
Date well completed July 28, 1950 19
Application for plugging filed August 21, 1950 19
Application for plugging approved August 21, 1950 19
Plugging commenced August 21, 1950 19
Plugging completed August 25, 1950 19
Reason for abandonment of well or producing formation Dry Hole
If a producing well is abandoned, date of last production none 19
Was permission obtained from the Conservation Division or its agents before plugging was commenced? Yes

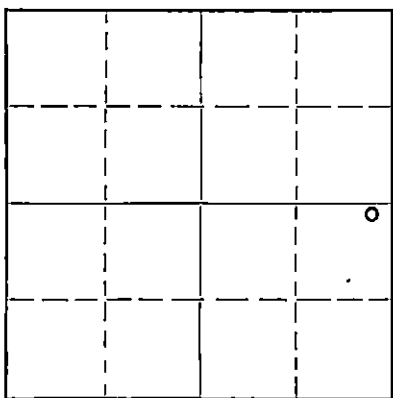

Locate well correctly on above Section Plat

Name of Conservation Agent who supervised plugging of this well C. D. Stough
Producing formation Depth to top Bottom Total Depth of Well 3498 Feet
Show depth and thickness of all water, oil and gas formations.

OIL, GAS OR WATER RECORDS

CASING RECORD

Formation	Content	From	To	Size	Put In	Pulled Out
				8 5/8"	154'	
				5 1/2"	3456'	3110'

Describe in detail the manner in which the well was plugged, indicating where the mud fluid was placed and the method or methods used in introducing it into the hole. If cement or other plugs were used, state the character of same and depth placed, from feet to feet for each plug set.

154 feet of 8 5/8" surface pipe circulated with cement. 5 1/2" casing set at 3454 feet. Plugged back to 3437 feet with chat. Dumped 5 sacks of cement at 3437 feet. Shot off and pulled the 5 1/2 inch casing. Filled with mud to 154 feet. Rock bridge and 15 sacks of cement at 154 feet. Filled with mud to 35 feet. Set bridge and 10 sacks of cement at the surface.

Plugging Contractor: R. & L. Pipe Pulling Co.

(If additional description is necessary, use BACK of this sheet)

Correspondence regarding this well should be addressed to H. C. Bennett
Address P. O. Box 31, Augusta, Kansas

STATE OF _____, COUNTY OF _____, ss.
_____(employee of owner) or (owner or operator) of the above-described well, being first duly sworn on oath, says: That I have knowledge of the facts, statements, and matters herein contained and the log of the above-described well as filed and that the same are true and correct. So help me God.

(Signature) x H. C. Bennett x
Box 31, Augusta, Kans.
(Address)

SUBSCRIBED AND SWORN to before me this 27th day of Sept. 1950

RECEIVED Greider x
STATE CORPORATION COMMISSION Notary Public.

My commission expires Jan. 31, 1953

22-7877-8 4-40-10M

SEP 28 1950

CONSERVATION DIVISION
Wichita, Kansas

PLUGGING
SEC 5 T 21 R 6W
PAGE 22 LINE 34

KANSAS
STATE COMMISSION
STATE COMMISSION
SEP 15 1950

0000-03803-0000

H. C. Bennett
Engelland # 3

NE NE SE Sec. 5-21S-6W
Rice County, Kansas

Total Depth: 3470'
Comm: 6-12-50
Comp: 6-24-50

Top: Mississippi Lime 3455' (-1804)

Casing

8 5/8" Set @ 154'
5 1/2" Set @ 3456'

Cement

125 Sacks of Victor
45 Sacks of Victor

Formation	Depth:
Sand	85
Sand-Shale	105
Shale-Shells	154
Shale-Shells-RedBed	325
Shale	635
Shale-Salt	930
Shale-Lime	960
Shale-Anhydrite	1115
Anhydrite	1130
Shale-Lime	1845
Shale-Shells	2025
Shale-Lime	2555
Lime	2725
Lime-Shale	2895
Lime	3215
Broken Lime	3295
Lime-Shale	3454
Lime	3470

Drilled in with Cable Tools.
A show of gas + oil at 3475'
a little water at 3480'
SS Drilled to total depth of 3498'
with no increase

STATE OF KANSAS)
RUSSELL COUNTY)

I hereby certify that the above information is true
and correct to the best of my knowledge.

Violet Keller

Subscribed and sworn to before me this 3rd day of July, 1950

Clara L. Lamm

Notary Public

My commission expires: 6-17-54

Plugging Record

8 5/8" 154' cement circulated

PLUGGING
FILE SEC 5-21-6W
BOOK PAGE 27 LINE 30

Filled with crushed rock, 3498' to 3437'.
Dumped 5 sacks cement.
5 1/2" casing recovered 3110'
Mudded hole to 154' 10' rock bridge with
15 sacks cement. Mud to 30' rock bridge
and 10 sacks cement.

Completed 8-25-50