


STATE OF KANSAS
STATE CORPORATION COMMISSION

Form CP-4

WELL PLUGGING RECORD

Give All Information Completely
Make Required Affidavit
Mail or Deliver Report to:
Conservation Division
State Corporation Commission
212 No. Market
Wichita, Kansas 67202

NORTH

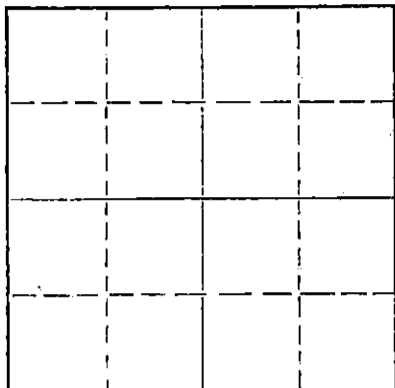

Locate well correctly on above
Section Flat

Rice County, Sec. 4 Twp. 21 Rge. 6 (E) (W)
Location as "NE/CNW/SW" or footage from lines C E/2 SE NE
Lease Owner Sterling Drilling Company
Lease Name Johnson A#8 Well No. _____
Office Address Sterling, Kansas 67579
Character of Well (completed as Oil, Gas or Dry Hole) _____
Date well completed _____ 19____
Application for plugging filed _____ 19____
Application for plugging approved _____ 19____
Plugging commenced 10/4/71 _____ 19____
Plugging completed 10/6/71 _____ 19____
Reason for abandonment of well or producing formation depleted.

If a producing well is abandoned, date of last production _____ 19____
Was permission obtained from the Conservation Division or its agents before plugging was commenced? yes

Name of Conservation Agent who supervised plugging of this well Scott
Producing formation _____ Depth to top _____ Bottom _____ Total Depth of Well 3491 Feet
Show depth and thickness of all water, oil and gas formations.

OIL, GAS OR WATER RECORDS

CASING RECORD

FORMATION	CONTENT	FROM	TO	SIZE	PUT IN	PULLED OUT
				8-5/8	106	none
				5 1/2"	3490	2911'

Describe in detail the manner in which the well was plugged, indicating where the mud fluid was placed and the method or methods used in introducing it into the hole. If cement or other plugs were used, state the character of same and depth placed, from _____ feet to _____ feet for each plug set.

Checked hole to 3461', ran sand to 3400' and dumped 5 sacks of cement, loaded hole. Shot pipe at 2911', pulled 92 joints pipe. Set rock bridge 190 to 180' and dumped 35 sacks of cement. Mud to 40', set rock bridge and dumped 10 sacks of cement.

PLUGGING COMPLETE.

RECEIVED
STATE CORPORATION COMMISSION
OCT 26 1971
CONSERVATION DIVISION
Wichita, Kansas

Name of Plugging Contractor KNIGHT CASING PULLING CO., INC.
Address CHASE, KANSAS

STATE OF KANSAS, COUNTY OF RICE, ss.
NOEL J. KNIGHT (employee of owner) or (owner or operator) of the above-described well, being first duly sworn on oath, says: That I have knowledge of the facts, statements, and matters herein contained and the log of the above-described well as filed and that the same are true and correct. So help me God.

(Signature) *Noel Knight*
CHASE, KANSAS
(Address)

SUBSCRIBER AND SWORN TO BY OWNER
MARGARET MELCHER
NOTARY PUBLIC
Rice County, Kansas
My Commission Expires
Feb. 15, 1975

7th day of October, 1971
Margaret Melcher
Notary Public.

T-45

STERLING DRILLING COMPANY
Sterling, Kansas

WELL LOG-----JOHNSON "A" #8

Location: E/2 SE 1/4, Section 4-21S-6W,
Rice County, Kansas

OWNER: Davis-Child et al
ROTARY DRILLING CONTRACTOR: Sterling Drilling Company
CABLE TOOL CONTRACTOR: Sterling Drilling Company

COMMENCED: 3-15-57 (w.r.)
3-26-57 (w.c.t.)
COMPLETED: 3-24-57 (w.r.)
4-7-57 (w.c.t.)

TOTAL DEPTH: 3491'

LOG

0-168	Sand, Shale & Shells	
168-870	Shale & Shells	
870-2390	Limestone & Shale	
2390-2595	Limestone	
2595-2835	Shale & Limestone	
2835-3000	Limestone	
3000-3095	Limestone & Shale	
3095-3195	Limestone	
3195-3405	Limestone & Shale	
3405-3415	Conglomerate	
3415-3485	Chat	
3485-3491	Shale	T.D.

CASING RECORD

Ran 160' of 8-5/8" casing set with 135
sacks cement, 2 sacks calcium chloride.

Set 5-1/2" casing at 3490' with 100
sacks cement.

CABLE TOOLS M.I.C.T. Rigged up and swabbed hole down. Perforated 3418 to 24 with 3
jets per foot. Acidized with 250 gal. Fractured with 3000# sand and 3000 gal. heavy oil.
Swabbed at rate of 15 B.F.P.H. P.O.P.

RECEIVED
STATE CORPORATION COMMISSION
SEP 17 1971
CONSERVATION DIVISION
Wichita, Kansas