


STATE OF KANSAS
STATE CORPORATION COMMISSION

Form CP-4

WELL PLUGGING RECORD

Give All Information Completely
Make Required Affidavit
Mail or Deliver Report to:
Conservation Division
State Corporation Commission
212 No. Market
Wichita, Kansas

NORTH

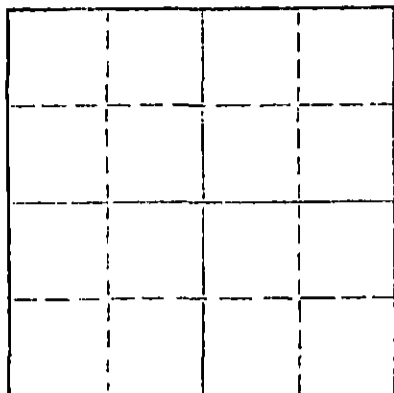

Locate well correctly on above
Section Plat

Rice County, Sec. 4 Twp. 21 Rge. 6 (E) (W)
Location as "NE/CNW/SW" or footage from lines. NW SW NE
Lease Owner Sterling Drilling Company
Lease Name Johnson A#5 Well No.
Office Address Sterling, Kansas 67579
Character of Well (completed as Oil, Gas or Dry Hole)
Date well completed 19
Application for plugging filed 19
Application for plugging approved 19
Plugging commenced ~~2/11/72~~ 2/11/72 19
Plugging completed ~~21~~ 2/15/72 19
Reason for abandonment of well or producing formation depleted.
If a producing well is abandoned, date of last production 19
Was permission obtained from the Conservation Division or its agents before plugging was commenced? yes

Name of Conservation Agent who supervised plugging of this well Toman
Producing formation Depth to top Bottom Total Depth of Well 3456 Feet
Show depth and thickness of all water, oil and gas formations.

OIL, GAS OR WATER RECORDS

CASING RECORD

FORMATION	CONTENT	FROM	TO	SIZE	PUT IN	PULLED OUT
				8-5/8	120	none
				5 1/2"	3419'	3077'

Describe in detail the manner in which the well was plugged, indicating where the mud fluid was placed and the method or methods used in introducing it into the hole. If cement or other plugs were used, state the character of same and depth placed, from feet to feet for each plug set.

Checked hole, ran sand to 3400' and dumped 5 sacks of cement.
Loaded hole, shot pipe at 3076', 2894', worked pipe loose and pulled 99 joints, had 2 shot joints. Bailed fluid to 210', set rock bridge and dumped 50 sacks of cement. Mudded to 40', set rock bridge and dumped 10 sacks of cement.

PLUGGING COMPLETE.

RECEIVED
STATE CORPORATION COMMISSION
FEB 23 1972
CONSERVATION DIVISION
Wichita, Kansas

(If additional description is necessary, use BACK of this sheet)
Name of Plugging Contractor KNIGHT CASING PULLING CO., INC.
Address CHASE, KANSAS

STATE OF KANSAS COUNTY OF RICE, ss.
NOEL J. KNIGHT (employee of owner) or (owner or operator) of the above-described well, being first duly sworn on oath, says: That I have knowledge of the facts, statements, and matters herein contained and the log of the above-described well as filed and that the same are true and correct. So help me God.

(Signature) Noel Knight
CHASE, KANSAS
(Address)

Subscribed and Sworn to before me this 17th day of February, 1972
MARGARET MELCHER
NOTARY PUBLIC
Rice County, Kansas
My Commission Expires Feb. 15, 1975

Margaret Melcher
Notary Public.

T-42.

STERLING DRILLING COMPANY

STERLING, KANSAS

WELL LOG ----- JOHNS N NO. 5

Location - NW SW NE of Section 4-21S-6W, Rice County, Kansas.

Owner - J. A. Davis and J. N. Child, et al
Contractor - Sterling Drilling Company

Commenced - 9-23-49
Completed - 9-2-49 (w/r)
 9-12-49 (c/t)

Total Depth - 3420' (w/r)
 3456' (c/t)

ELEVATION - 1617 D.F.
 1614 Gr.

RECEIVED
STATE CORPORATION COMMISSION
JAN 14 1972
CONSERVATION DIVISION
Wichita, Kansas

LOG

0- 30 Sand
30- 120 Shale
120- 170 Shale and Red Bed
170- 715 Shale and Shells
715- 895 Salt and Shells
895-1450 Shale and Lime
1450-1530 Lime and Sand
1530-1535 Shale and Shells
1535-1955 Lime and Shale
1955-2135 Shale and Broken Lime
2135-2460 Lime and Shale
2460-2665 Lime
2665-2770 Sandy Shale
2770-2325 Lime
2325-2930 Lime and Shale
2930-2995 Sand and Shale
2995-3250 Lime
3250-3340 Lime and Shale
3340-3407 Shale
3407-3417 Conglomerate
3417-3420 Mississippi
3420-3456 Cable Tools

CASING RECORD

120 Feet 8-5/8" Surface Pipe
Cemented with 100 Sacks Cement

5 1/2-inch Casing Set @ 3419'
Cemented with 50 Sacks Cement.

PRODUCTION

Producer.

STERLING DRILLING COMPANY

STERLING, KANSAS

WELL LOG ----- JOHN N NO. 5

Location - NW SW NE of Section 4-21S-6W, Rice County, Kansas.

Owner - J. W. Davis and J. H. Child, et al
Contractor - Sterling Drilling Company

Commenced - 3-23-49
Completed - 9-2-49 (w/r)
 9-12-49 (c/t)

Total Depth - 3420' (w/r)
 3456' (c/t)

ELEVATION - 1617 D.F.
 1614 Cr.

LOG

- 0- 30 Sand
- 30- 120 Shale
- 120- 170 Shale and Red Bed
- 170- 715 Shale and Shells
- 715- 895 Salt and Shells
- 895-1450 Shale and Lime
- 1450-1830 Lime and Sand
- 1830-1935 Shale and Shells
- 1935-1955 Lime and Shale
- 1955-2135 Shale and Broken Lime
- 2135-2460 Lime and Shale
- 2460-2665 Lime
- 2665-2770 Sandy Shale
- 2770-2825 Lime
- 2825-2930 Lime and Shale
- 2930-2995 Sand and Shale
- 2995-3250 Lime
- 3250-3340 Lime and Shale
- 3340-3407 Shale
- 3407-3417 Conglomerate
- 3417-3420 Mississippi
- 3420-3456 Cable Tools

CASING RECORD

120 Feet 8-5/8" Surface Pipe
Cemented with 100 Sacks Cement

5 1/2-inch Casing Set to 3419'
Cemented with 50 Sacks Cement.

PRODUCTION

Producer.

RECEIVED
STATE CORPORATION COMMISSION
FEB 23 1972
CONSERVATION DIVISION
Wichita, Kansas