


STATE OF KANSAS
STATE CORPORATION COMMISSION

WELL PLUGGING RECORD

Give All Information Completely
Make Required Affidavit
Mail or Deliver Report to:
Conservation Division
State Corporation Commission
800 Biting Building
Wichita, Kansas

Rice County, Sec. 4 Twp. 21S Rge. (E) 6 (W) NW SW NW

Location as "NE/CNW $\frac{1}{4}$ SW $\frac{1}{4}$ " or footage from lines
Lease Owner Seeger Oil & Gas Company
Lease Name Clevinger Well No. 3
Office Address 401 South Washington, Hutchinson, Kansas
Character of Well (completed as Oil, Gas or Dry Hole) Dry Hole
Date well completed August 15, 19 49
Application for plugging filed September 5, 19 49
Application for plugging approved September 5, 19 49
Plugging commenced September 5, 19 49
Plugging completed September 9, 19 49
Reason for abandonment of well or producing formation Dry Hole

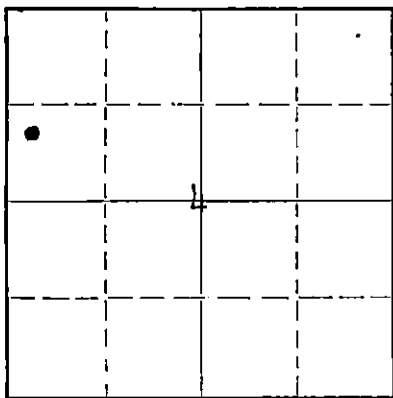

Locate well correctly on above
Section Plat

If a producing well is abandoned, date of last production 19
Was permission obtained from the Conservation Division or its agents before plugging was commenced? Yes

Name of Conservation Agent who supervised plugging of this well Ruel Durkee
Producing formation Depth to top Bottom Total Depth of Well 3461 Feet
Show depth and thickness of all water, oil and gas formations.

OIL, GAS OR WATER RECORDS

CASING RECORD

Formation	Content	From	To	Size	Put In	Pulled Out
				8-5/8"	171	
				5-1/2"	3431	3257'

Describe in detail the manner in which the well was plugged, indicating where the mud fluid was placed and the method or methods used in introducing it into the hole. If cement or other plugs were used, state the character of same and depth placed, from feet to feet for each plug set.

Filled with heavy gravel to 3420'. Dumped 6 sacks cement.
Set plug, dumped 15 sacks cement at 165'. Filled hole up to approximately 15' of top with heavy mud. Dumped 5 sacks cement.

RECEIVED
CONSERV. DIV.
OCT 26 1949
STATE CORPORATION
COMMISSION
KANSAS

(If additional description is necessary, use BACK of this sheet)
Correspondence regarding this well should be addressed to Seeger Oil & Gas Company
Address 401 South Washington, Hutchinson, Kansas


STATE OF Kansas, COUNTY OF Rice, ss.
Rollin Mead (employee of owner) or (owner or operator) of the above-described well,
being first duly sworn on oath, says: That I have knowledge of the facts, statements, and matters herein contained and the log of the above-described well as filed and that the same are true and correct. So help me God.

(Signature) Rollin Mead
Sterling, Kansas
(Address)

SUBSCRIBED AND SWORN to before me this 24th day of October, 19 49.

[Signature]
Notary Public.

My commission expires September 17, 1953.

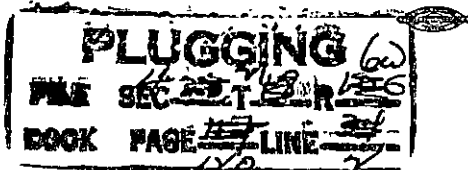

STERLING DRILLING COMPANYSTERLING, KANSAS

WELL LOG

CIEVINGER NO. 3

Location - NW SW NW of Section 4-21S-6W, Rice County, Kansas.

Owner - Seeger Oil and Gas Co., Inc., et al

Contractor - Sterling Drilling Company

Commenced - 7-18-49

Completed - 7-29-49 (w/r)

8-15-49 (c/t)

Total Depth - 3433' (w/r)
3532' (c/t)ELEVATION - 1648 D.F.LOG

0- 145 Sand and Shells
 145- 155 Sand
 155- 171 Red Rock & Shells
 171- 510 Red Bed & Shale
 510- 795 Shale and Lime Shells
 795- 850 Salt and Shells
 850-1120 Shale and Shells
 1120-1350 Shale and Lime
 1350-1455 Lime and Sand Shale
 1455-1630 Broken Lime
 1630-1765 Lime
 1765-1865 Broken Lime
 1865-1895 Shale - Soft
 1895-2070 Shale and Shells
 2070-2285 Shale and Lime
 2285-2320 Lime
 2320-2405 Lime and Shale
 2405-2710 Lime
 2710-2820 Shale
 2820-2900 Shale and Lime
 2900-3335 Lime
 3335-3429 Shale
 3429-3431 Conglomerate
 3431-3433 Chat
 3433-3532 Cable Tools

GASING RECORD171 Feet 8-5/8" Surface Pipe
Cemented with 125 Sacks Cement3431 Feet 5-1/2" O.D. Casing
Cemented with 30 Sacks CementPRODUCTION

None. Dry and Abandoned.

Plugged back to 3461, shot with 50 qts. Nitro.
Cleaned out to 3461.**RECEIVED**

OCT 2 6 1949

STATE CORPORATION
COMMISSION
KANSAS