


STATE OF KANSAS  
STATE CORPORATION COMMISSION

WELL PLUGGING RECORD

Give All Information Completely  
Make Required Affidavit  
Mail or Deliver Report to:  
Conservation Division  
State Corporation Commission  
211 No. Broadway  
Wichita, Kansas

Stafford County. Sec. 34 Twp. 21 Rgs. 13W E (E) (W)

Location as "NE/CNW/SW" or footage from lines NE - 34 - SE  
Lease Owner Barton George Kaiser, Oil Producer  
Lease Name Fisher Well No. 1  
Office Address Millwood, Kansas  
Character of Well (completed as Oil, Gas or Dry Hole) \_\_\_\_\_  
Date well completed \_\_\_\_\_ 19\_\_\_\_  
Application for plugging filed \_\_\_\_\_ 19\_\_\_\_  
Application for plugging approved \_\_\_\_\_ 19\_\_\_\_  
Plugging commenced 12-27 1958  
Plugging completed 1-2 1959  
Reason for abandonment of well or producing formation \_\_\_\_\_

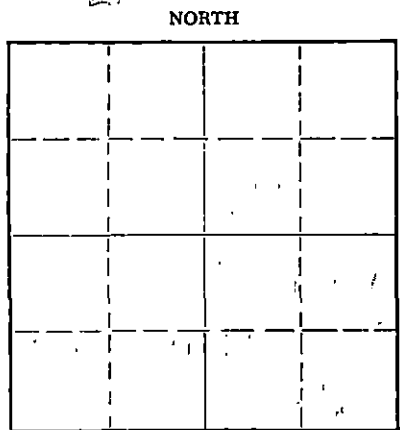

Locate well correctly on above  
Section Flat

If a producing well is abandoned, date of last production \_\_\_\_\_ 19\_\_\_\_  
Was permission obtained from the Conservation Division or its agents before plugging was commenced? Yes

Name of Conservation Agent who supervised plugging of this well Frank Bradford  
Producing formation \_\_\_\_\_ Depth to top \_\_\_\_\_ Bottom \_\_\_\_\_ Total Depth of Well \_\_\_\_\_ Feet  
Show depth and thickness of all water, oil and gas formations.

OIL, GAS OR WATER RECORDS

CASING RECORD

FORMATION	CONTENT	FROM	TO	SIZE	PUT IN	PULLED OUT
				5 5/8	252	None
				5 1/2	3525	2022.78

Describe in detail the manner in which the well was plugged, indicating where the mud fluid was placed and the method or methods used in introducing it into the hole. If cement or other plugs were used, state the character of same and depth placed, from \_\_\_\_\_ feet to \_\_\_\_\_ feet for each plug set.

Runned to 3600' - dumped 5 aka cement - pulled pipe -  
runned to 375' - set rock bridge and dumped 20 aka cement - runned to 35'  
set rock bridge - dumped 10 aka cement.

RECEIVED  
STATE CORPORATION COMMISSION

FEB 27 1959

CONSERVATION DIVISION  
Wichita, Kansas

(If additional description is necessary, use BACK of this sheet)

Name of Plugging Contractor R & B Casing Pulling Company License # 236  
Address Box 369 Millwood, Kansas

STATE OF Kansas, COUNTY OF Barton, ss.  
W. J. Hall (employee of owner) or (owner or operator) of the above-described well, being first duly sworn on oath, says: That I have knowledge of the facts, statements, and matters herein contained and the log of the above-described well as filed and that the same are true and correct. So help me God.

(Signature) W. J. Hall

(Address)

SUBSCRIBED AND SWORN TO before me this 16 day of January, 1958  
Delmer L. Postler

Notary Public.

My commission expires \_\_\_\_\_

PLUGGING  
FILE SEC 34 T 21 R 13W  
BOOK PAGE 69 LINE 27

DRILLER'S LOG

Herman Geo. Kaiser  
 #1 Fischer  
 NW SW SE 34-215-13W  
 Stafford County, Kansas

TO	FROM	
0	245	Surface Clay & Sand
245	282	Red Pack
282	725	Red shale & Shells
725	752	Anhydrite
752	1030	Shale & Shells
1030	1550	Shale, Salt & Shells
1550	1805	Lime & Shale
1805	1895	Lime & Shale
1895	2000	Lime
2000	2270	Lime & Shale
2270	2450	Shale & Lime
2450	2680	Shale & Shells
2680	2770	Lime & Shale
2770	2910	Shale & Lime
2910	3140	Lime & shale
3140	3195	Lime
3195	3310	Lime & Shale
3310	3322	Shale & Lime
3322	3340	Br. Lime
3340	3380	L. Lime
3380	3533	Lime
3533	3586	Lime & Shale
3586	3610	Shale, Lime, Chert
3610	3651	Viola
3651	3658	Shale & Sand
3658	3709	Shale & Lime
3709	3711	Lime
	3711	ROD ONLY TOTAL DEPTH

COMMENCED: 3-14-55  
 COMPLETED: 3-23-55

CASING RECORD:

Set 282' of 8 5/8" surface casing with 200 sacks cement.

D & A

STATE OF KANSAS )  
 ) SS  
 COUNTY OF SEBASTIAN )

I hereby affirm that the above and foregoing is a true and correct copy of the log of the #1 Fischer located NW SW SE of Section 34-215-13, Stafford County, Kansas.

ANSCHUTZ DRILLING CO., INC.

BY: E. G. Koelling

Subscribed and sworn to before me this 25th day of March, 1955.

My Commission expires: July 28, 1958.

Notary Public  
**PLUGGING**  
 FILE SEC 34 T. 21 R. 13W  
 BOOK PAGE 69 LINE 27