

15.185.20859.0000

STATE OF KANSAS
STATE CORPORATION COMMISSION


WELL PLUGGING RECORD

Give All Information Completely
Make Required Affidavit
Mail or Deliver Report to
Conservation Division
State Corporation Comm.
245 North Water
Wichita, KS 67202

Stafford County. Sec. 34 Twp. 21s Rge. 13W E/W
Location as "NE/CNW $\frac{1}{4}$ /SW $\frac{1}{4}$ " or footage from lines
NW SE SE

Lease Owner Arrowhead Petroleum, Inc.
Lease Name Fischer Well No. 1

Office Address Box 8287, Munger Station, Wichita, KS
Character of Well (Completed as Oil, Gas or Dry Hole) Dry Hole

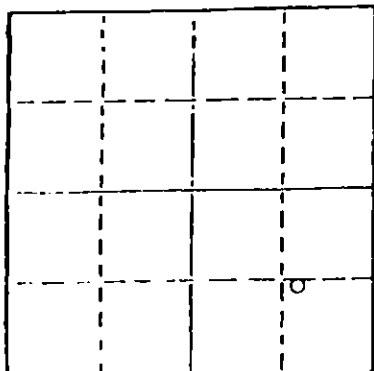

Locate well correctly on above
Section Plot

Date Well completed 10-15 1978
Application for plugging filed 10-15 1978
Application for plugging approved 10-15 1978
Plugging commenced 10-15 1978
Plugging completed 10-15 1978

Reason for abandonment of well or producing formation Dry Hole

If a producing well is abandoned, date of last production N/A 19

Was permission obtained from the Conservation Division or its agents before plugging was commenced? yes

Name of Conservation Agent who supervised plugging of this well Wm T. Owens
Producing formation _____ Depth to top _____ Bottom _____ Total Depth of Well 3700
Show depth and thickness of all water, oil and gas formations.

OIL, GAS OR WATER RECORDS

CASING RECORD

FORMATION	CONTENT	FROM	TO	SIZE	PUT IN	PULLED OUT
Sand and Shale				8 5/8	291'	None

Describe in detail the manner in which the well was plugged, indicating where the mud fluid was placed and the method or methods used in introducing it into the hold. If cement or other plugs were used, state the character of same and depth placed, from _____ feet to _____ feet for each plug set.

40 sx 540'
40 sx 290'
12 sx 40'
3 sx Rat Hole
50-50 PAZ 2% gel

RECEIVED
STATE CORPORATION COMMISSION

OCT 19 1978

10-19-78

CONSERVATION DIVISION
Wichita, Kansas

(If additional description is necessary, use BACK of this sheet)

Name of Plugging Contractor Service Company

STATE OF Kansas COUNTY OF Sedgwick, ss.
Paul A. Seymour, Jr. (employee of owner) or (owner or operator)
of the above-described well, being first duly sworn on oath, says: That I have knowledge of the facts, statements, and matters herein contained and the log of the above-described well as filed and that the same are true and correct. So help me God.

(Signature) Paul A. Seymour Jr.
Box 8287, Munger Station Wichita, KS
(Address)

SUBSCRIBED AND SWORN TO before me this 18th day of October, 1978

Ruth M. Bassett
Ruth M. Bassett Notary Public.

My commission expires May 30, 1979

BIG SPRINGS DRILLING, INC.

P.O. BOX 8287
MUNGER STATION
WICHITA, KANSAS 67208

SUITE 29 • 400 NORTH WOODLAWN • (316) 681-1732

October 17, 1978

DRILLERS LOG

Re: Fischer No. 1
NW SE SE
Sec. 34 - Twp 21s - Rq 13W
Stafford County, Kansas

OPERATOR: Arrowhead Petroleum, Inc.
CONTRACTOR: Big Springs Drilling, Inc.
COMMENCED: 10-7-78
COMPLETED: 10-15-78

Surface Pipe: 8 5/8" 291' W/250 sx Common 2% gel 3% ccl

0	291	Sand and Shale
291	730	Shale, Salt, Sand
730	736	Anhydrite
736	1711	Shale and Shells
1711	1975	Shale
1975	3075	Lime and Shale
3075	3700	Lime
3700		RTD

RECEIVED
STATE CORPORATION COMMISSION
OCT 19 1978
CONSERVATION DIVISION
Wichita, Kansas

We certify that the above and foregoing is a true and correct copy of the log on the # 1 Fischer located in Stafford County, Kansas.

BIG SPRINGS DRILLING, INC.


Paul A. Seymour, Jr.

Subscribed and sworn to before me this 18th day of October, 1978.

My Commission Expires:

May 30, 1979


Ruth M. Bassett Notary Public