


STATE OF KANSAS  
STATE CORPORATION COMMISSION

File All Information Completely  
State Required Affidavit  
Must be Delivered Report to  
Conservation Division  
State Corporation Commission

P. O. Box 17027  
Wichita, Kansas 67217

WELL PLUGGING RECORD

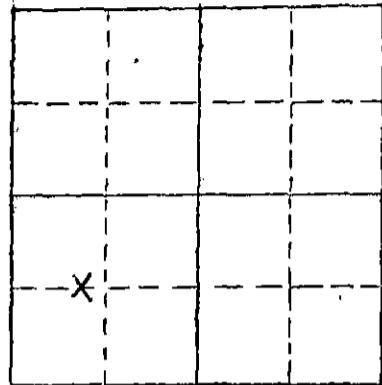

Locate well correctly on above  
Section Plat

Stafford County, Sec 34 Twp 21 Rge 13 (E)W (W)  
Location as "NE/CN/WSW4" or footage from lines C E/2 W/2 SW  
Lease Owner Joe Brougher Oil Co.  
Lease Name Gates Well No. #8  
Office Address 5513 Apache ; Great Bend, Kansas 67530  
Character of Well (completed as Oil, Gas or Dry Hole)  
Date well completed 19  
Application for plugging filed November 19 73  
Application for plugging approved November 19 73  
Plugging commenced December 3 19 73  
Plugging completed February 8 19 74  
Reason for abandonment of well or producing formation

If a producing well is abandoned, date of last production 19  
Was permission obtained from the Conservation Division or its agents before plugging was commenced? Yes

Name of Conservation Agent who supervised plugging of this well Russell Biberstein  
Producing formation Depth to top Bottom Total Depth of Well Feet  
Show depth and thickness of all water, oil and gas formations.

OIL, GAS OR WATER RECORDS

CASING RECORD

FORMATION	CONTENT	FROM	TO	SIZE	PUT IN	PULLED OUT
				8 5/8"	268	None
				5 1/2"	3728	1727

Describe in detail the manner in which the well was plugged, indicating where the mud fluid was placed and the method or methods used in introducing it into the hole. If cement or other plugs were used, state the character of same and depth placed, from feet to feet for each plug set.

December 3, 1973 Plugged off bottom. Dumped sand to 3700'.  
Mixed and dumped 5 sx of cement.

February 8, 1974 Plugged off top. Allied Cementing Co. mixed  
and pumped down 8 5/8" surface casing ; 3 sx  
of hulls, 20 sx of gel and 125 sx of cement.

RECEIVED  
STATE CORPORATION COMMISSION  
APR 3 - 1974  
CONSERVATION DIVISION  
Wichita, Kansas

RECEIVED  
STATE CORPORATION COMMISSION  
APR 3 - 1974  
CONSERVATION DIVISION  
Wichita, Kansas

Name of Plugging Contractor, RUSS CASING PULLING, INC.  
Address P. O. Box 1082 ; Great Bend, Kansas 67530

STATE OF Kansas COUNTY OF Barton ss.  
Joe Brougher d/b/a Joe Brougher Oil Co. (employee of owner) or (owner or operator) of the above-described


well, being first duly sworn on oath, says: That I have knowledge of the facts, statements, and matters herein contained and the log of the above-described well as filed and that the same are true and correct. So help me God.

(Signature) Joe Brougher  
5513 Apache, Great Bend, Kansas 67530  
(Address)

Subscribed and sworn to before me this 2nd day of April 19 74

Viann Brougher Notary Public.

My commission expires September 26, 1976

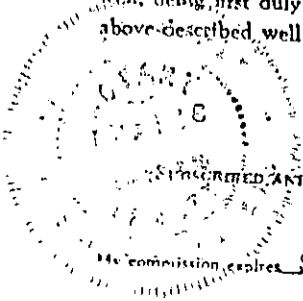

LEO J. DREILING AND SONS, INC.  
VICTORIA, KANSAS

WELL LOG

*75 sacks common cement*

Company LEO J. DREILING OIL COMPANY  
VICTORIA, KANSAS

Sec. 34 Twp. 21 Rng. 13

Farm GATES No. 8

Location C/E2 W2 SW

Total Depth 3730'

County STAFFORD COUNTY, KANSAS

Comm. 4-26-61 Comp. 5-4-61

Elevation: D. F. 1889

Contractor

G. R. 1886

Casing Record

Cement Record

Production:

8 5/7 - - - 268'

230 SAGS CEMENT

ARBUCKLE

Figures Indicate Bottom of Formations

0 - 101	SAND & GRAVEL
101 - 230	SAND & SHALE
230 - 268	RED ROCK SHALE
268 - 450	SHALE & SAND
450 - 729	RED ROCK
729 - 735	ANHYDRITE
735 - 760	ANHYDRITE
760 - 1110	RED ROCK
1110 - 1740	SHALE
1740 - 1875	LIME
1875 - 2030	LIME & SHALE
2030 - 2170	LIME
2170 - 2290	LIME
2290 - 2570	LIME & SHALE
2570 - 2825	SHALE & BROKEN LIME
2825 - 2960	SHALE
2960 - 3100	SHALE & LIME
3100 - 3185	LIME
3185 - 3255	LIME
3255 - 3380	LIME
3380 - 3443	LIME
3443 - 3510	LIME
3510 - 3580	LIME
3580 - 3629	LIME
3629 - 3681	LIME
3681 - 3710	LIME CHIRT
3710 - 3730	LIME
3730	TD

RECEIVED  
STATE CORPORATION COMMISSION  
NOV 29 1973  
CONSERVATION DIVISION  
Wichita, Kansas

STATE OF KANSAS, COUNTY OF ELLIS, ss.

I, Leo J. Dreiling, of the L. J. Dreiling & Sons, Inc., upon oath states that the above and foregoing is a true and correct copy of the log from the Daily Drilling Report on your Gates # 8.

LEO J. DREILING

Subscribed and sworn to before me this 22th day of May, 1961.

NOTARY PUBLIC

My Commission Expires: \_\_\_\_\_