


WELL PLUGGING RECORD

Give All Information Completely
Make Required Affidavit
Mail or Deliver Report to:
Conservation Division
State Corporation Commission
211 No. Broadway
Wichita, Kansas

NORTH

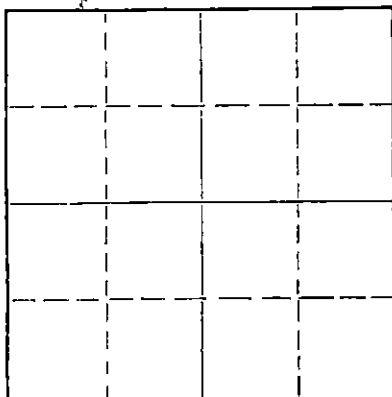

Locate well correctly on above Section Plat

Stafford County, Sec. 34 Twp. 21 Rge. 13 (E) (W)
Location as "NE/CNW&SW&" or footage from lines NW SW SW
Lease Owner Leo J. Dreiling Oil Company
Lease Name Gates Well No. 4
Office Address Victoria, Kansas
Character of Well (completed as Oil, Gas or Dry Hole) Oil Well
Date well completed 1-22-53 19 53
Application for plugging filed May 4 19 61
Application for plugging approved May 4 19 61
Plugging commenced May 4 19 61
Plugging completed May 4 19 61
Reason for abandonment of well or producing formation Oil in formation exhausted
If a producing well is abandoned, date of last production April 1961
Was permission obtained from the Conservation Division or its agents before plugging was commenced? Yes

Name of Conservation Agent who supervised plugging of this well ?
Producing formation Kansas City Depth to top 3370' Bottom 3458' Total Depth of Well 3746' Feet
Show depth and thickness of all water, oil and gas formations.

OIL, GAS OR WATER RECORDS

CASING RECORD

Table with 7 columns: FORMATION, CONTENT, FROM, TO, SIZE, PUT IN, PULLED OUT. Row 1: Surface Pipe, 8 5/8", 261', -0-

Describe in detail the manner in which the well was plugged, indicating where the mud fluid was placed and the method or methods used in introducing it into the hole. If cement or other plugs were used, state the character of same and depth placed, from feet to feet for each plug set.

Plugged back with sand from 3458' to 3370', mixed and dumped 5 sacks cement from 3370' to 3330', mudded hole to a depth of 210', set 10' fock bridge from 210' to 200', mixed and dumped 10 sacks cement from 200' to 170', mixed and dumped 10 more sacks cement which cemented from 170' to 140', mudded hole from 140' to 40', set rock bridge from 40' to 30' mixed and dumped 10 sacks cement 30' to base cellar.

RECEIVED
STATE CORPORATION COMMISSION
AUG 23 1962
CONSERVATION DIVISION
WICHITA, KANSAS

(If additional description is necessary, use BACK of this sheet)
Name of Plugging Contractor Ace Pipe Pulling Co.
Address Great Bend, Kansas

STATE OF Kansas, COUNTY OF Ellis, ss.
I, Leo F. Dreiling a partner, of the above-described well, being first duly sworn on oath, says: That I have knowledge of the facts, statements, and matters herein contained and the log of the above-described well as filed and that the same are true and correct. So help me God.

(Signature) Leo F. Dreiling
Leo F. Dreiling

(Address)

SUBSCRIBED AND SWORN TO before me this 17th day of August, 1962

Kenneth Zimmerman
Notary Public.

My commission expires August 14, 1965



L. J. DREILING and SONS, Inc.  
VICTORIA, KANSAS

WELL LOG

Company	Leo J. Dreiling Oil Company Victoria, Kansas	Sec.	34	Twp.	21	Rng.	13
Farm	Gates No. 4	Location	NW SW SW				
Total Depth	3746'	County	Stafford County				
Comm.	1-10-53	Comp.	1-22-53	Elevation:	D. F. 1890'		
Contractor	Charles Hulme Drilling Great Bend, Kansas				G. R. 1887'		
	Casing Record 261' - - - - 8 5/8"	Cement Record	175 sacks cement		Production:	D & A	

Figures Indicate Bottom of Formations

0 - 225	Surface Clay
225 - 258	Shale
258 - 730	Red Bed
730 - 760	Anhydrite
760 - 1400	Shale & Shells
1400 - 1665	Shale & Lime
1665 - 2145	Lime
2145 - 2375	Lime & Shale
2375 - 2740	Shale
2740 - 2845	Shale & Lime
2845 - 2940	Shale
2940 - 3063	Lime
3063 - 3125	Shale & Lime
3125 - 3210	Lime
3210 - 3257	Lime & Shale
3257 - 3340	Shale & Lime
3340 - 3645	Lime
3645 - 3722	Chert & Lime
3722 - 3746	Shale
3746	TD

**RECEIVED**  
STATE CORPORATION COMMISSION  
AUG 23 1962  
CONSERVATION DIVISION  
Wichita, Kansas

STATE OF KANSAS )  
                          ) ss.  
COUNTY OF ELLIS )

I, Leo F. Dreiling, of the Leo J. Dreiling Oil Company upon oath states that the above and foregoing is a true and correct copy of the Daily Drilling Report on your Gates No. 4.

Leo F. Dreiling  
Leo J. Dreiling Oil Company  
By: Leo F. Dreiling

Subscribed and sworn to before me this 17th day of August, 1962.

Roman Zimmerman  
Notary Public

My Commission Expires: August 14, 1965