


STATE OF KANSAS
STATE CORPORATION COMMISSION

WELL PLUGGING RECORD

Give All Information Completely.
Make Required Affidavit
Mail or Deliver Report to
Conservation Division
State Corporation Comm.
245 North Water
Wichita, KS 67202

Stafford County. Sec. 34 Twp. 21 Rge. 13 E/W
Location as "NE/CNW $\frac{1}{4}$ SW $\frac{1}{4}$ " or footage from lines _____

SW NE SW
Lease Owner Brouger Oil, Inc.
Lease Name Gates "A" Well No. 12
Office Address Drawer 1367, Great Bend, Kansas 67530
Character of Well (Completed as Oil, Gas or Dry Hole) _____

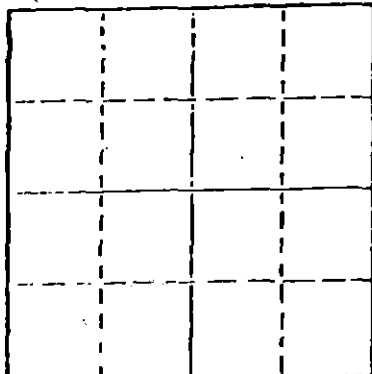

Locate well correctly on above
Section Plot

dry hole
Date Well completed Dec. 28 1980
Application for plugging filed Dec. 28 1980
Application for plugging approved Dec. 28 1980
Plugging commenced Dec. 28 1980
Plugging completed Dec. 28 1980
Reason for abandonment of well or producing formation _____
dry hole

If a producing well is abandoned, date of last production 19 _____

Was permission obtained from the Conservation Division or its agents before plugging was commenced? yes

Name of Conservation Agent who supervised plugging of this well Wm. T. Owen
Producing formation _____ Depth to top _____ Bottom _____ Total Depth of Well 3800
Show depth and thickness of all water, oil and gas formations.

OIL, GAS OR WATER RECORDS

CASING RECORD

FORMATION	CONTENT	FROM	TO	SIZE	PUT IN	PULLED OUT
				8 5/8	305	

Describe in detail the manner in which the well was plugged, indicating where the mud fluid was placed and the method or methods used in introducing it into the hold. If cement or other plugs were used, state the character of same and depth placed, from _____ feet to _____ feet for each plug set.

1st plug 480 w/50 sx.
2nd plug 300 w/30 sx.
3rd plug 40 w/10 sx
5 sx in rathole

(If additional description is necessary, use BACK of this sheet)

Name of Plugging Contractor Woodman & Iannitti Drilling Co.

STATE OF KANSAS COUNTY OF SEDGWICK, ss.
K. T. Woodman (employee of owner) or (owner or operator)

of the above-described well, being first duly sworn on oath, says: That I have knowledge of the facts, statements, and matters herein contained and the log of the above-described well as filed and that the same are true and correct. So help me God.

(Signature) K. T. Woodman
1008 Douglas Bldg.
(Address)

SUBSCRIBED AND SWORN TO before me this 31st day of December, 19 81

My commission expires Feb. 11, 1984
Justina Chamberlain Notary Public.

JAN 5 1981 1-5-81
CONSERVATION DIVISION
Wichita, Kansas

15.185.21186.0000

K. T. WOODMAN
RES. PHONE 733-0418
OFF. PHONE 265-7650
WICHITA, KANSAS

D. J. IANNITTI
PHONE 792-2921
GREAT BEND, KANSAS

WOODMAN & IANNITTI DRILLING COMPANY

Rotary Drilling Contractors

1008 DOUGLAS BUILDING
104 S. BROADWAY
WICHITA, KANSAS 67202

December 31, 1980

Company;	Brougner Oil, Inc.
Farm;	#12 Gates "A"
Location;	SW NE SW
Section;	34-21-13W
County;	Stafford
Contractor;	Woodman & Iannitti Drilling Co.
Comm;	December 18, 1980
Compl;	December 28, 1980
Total Depth;	3800
Casing;	8 5/8 @ 305 w/250 sx.
Production;	D & A

Figures Indicate Bottom Of Formations;

305	Surface
539	Shale & redbed
729	Redbed
756	Anhy
1620	Shale
1861	Shale
2363	Shale & lime
2610	Shale
2960	Shale & lime
3300	Lime & shale
3420	Shale & lime
3509	Lime & shale
3680	Lime
3760	Lime
3800	Total Depth

I certify the above to be a true and correct copy of the drillers log to the best of my knowledge and belief.

Woodman & Iannitti Drilling Co.
K. T. Woodman
K. T. Woodman

RECEIVED
CONSERVATION DIVISION

JAN 5 1981

CONSERVATION DIVISION
Wichita, Kansas