


WELL PLUGGING RECORD

Give All Information Completely
Make Required Affidavit
Mail or Deliver Report to:
Conservation Division
State Corporation Commission
800 Bitting Building
Wichita, Kansas

NORTH

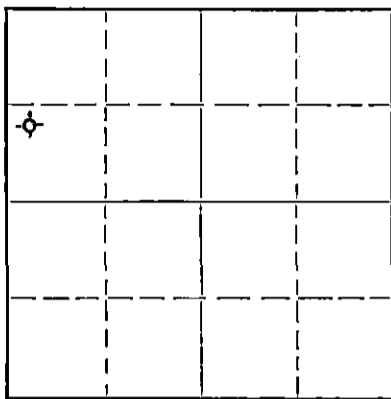

Locate well correctly on above Section Plat

Stafford

County. Sec. 34 Twp. 21S Rge. 13W (E).....(W)
Location as "NE/CNW $\frac{1}{4}$ SW $\frac{1}{4}$ " or footage from lines NW $\frac{1}{4}$ SW $\frac{1}{4}$ NW $\frac{1}{4}$
Lease Owner Birmingham-Bartlett Drilling Co.
Lease Name McCoy Well No. 1
Office Address 300 Kaufman Building, Wichita 2, Kansas
Character of Well (completed as Oil, Gas or Dry Hole) Dry Hole
Date well completed February 12 19 52
Application for plugging filed. (verbal approval rec'd) February 12 19 52
Application for plugging approved. " " " February 12 19 52
Plugging commenced February 12 19 52
Plugging completed February 12 19 52
Reason for abandonment of well or producing formation Dry Hole

If a producing well is abandoned, date of last production -- 19 --
Was permission obtained from the Conservation Division or its agents before plugging was commenced? Yes

Name of Conservation Agent who supervised plugging of this well C. D. Stough
Producing formation Arbuckle Depth to top 3747 Bottom 3756 Total Depth of Well 3756 Feet
Show depth and thickness of all water, oil and gas formations.

OIL, GAS OR WATER RECORDS

CASING RECORD

Formation	Content	From	To	Size	Put In	Pulled Out
		0	263'	8-5/8	263'	None

Describe in detail the manner in which the well was plugged, indicating where the mud fluid was placed and the method or methods used in introducing it into the hole. If cement or other plugs were used, state the character of same and depth placed, from.....feet to.....feet for each plug set.

Bottom plug at 250' - 15 sacks cement mixed and poured through pipe. Top plug at 40' - 10 sacks cement on top.

FEB 16 1952

2-12-52

(If additional description is necessary, use BACK of this sheet)

Correspondence regarding this well should be addressed to Birmingham-Bartlett Drilling Co.
Address 300 Kaufman Building, Wichita, Kansas

STATE OF KANSAS, COUNTY OF SEDGWICK
Richard Hindery, partner of owner and operator (Birmingham-Bartlett Drilling Co.)
(employee of owner) or (owner or operator) of the above-described well,
being first duly sworn on oath, says: That I have knowledge of the facts, statements, and matters herein contained and the log of the above-described well as filed and that the same are true and correct. So help me God.

(Signature) Richard Hindery
300 Kaufman Building, Wichita 2, Kansas
(Address)

SUBSCRIBED AND SWORN to before me this 15th day of February, 19 52.

Walter J. Ginger
Notary Public.

My commission expires November 29, 1954.

PLUGGING
FILE SEC 34 T 21 R 130
PAGE 14 LINE 13

McCOY #1 WELL

LOCATION: NW $\frac{1}{4}$ SW $\frac{1}{4}$ NW $\frac{1}{4}$ Sec. 34-218-13W Stafford County, Kansas SPUDDED: 1-31-62
 OPERATOR & CONTRACTOR: Birmingham-Bartlett Drilling Co. COMPLETED: 2-12-62
 SURFACE CASING: 8-5/8" casing cemented at 263' with 250 sacks and 2 c.c.
 OIL STRING: None Run - D & A

LOG

(Figures indicate bottom of formation)

0 to	220	Sand and Shells	
	318	Shale and Shells	
	732	Shale and Red Rock	Anhydrite
	1660	Shale and Shells	
	2155	Lime	
	2295	Lime and Shale	
	2460	Shale and Shells	
	2640	Shale	
	3040	Lime and Shale	
	3252	Lime	
	3320	Sandy Shale	
	3805	Lime	
	3645	Lime and Shale	
	3695	Lime	
	3707	Shale	
	3747	Shale and Sand	
	3750	Lime	
	3756	Arbuckle - Total Depth	

The undersigned Richard Hindery of the Birmingham-Bartlett Drilling Co. hereby certifies that the above is a true and correct log of the formations encountered in drilling the McCoy #1 Well as shown on the daily drilling reports.

BIRMINGHAM-BARTLETT DRILLING CO.

By Richard Hindery

Subscribed and sworn before me
 this 15th day of February, 1962.

Wm. L. Younger
 Notary Public

My commission expires November 29, 1964.

PLUGGING

FILE SEC 34 T-21 R(13)
 PAGE 174 LINE 13

FEB 16 1962
 BIRMINGHAM-BARTLETT DRILLING CO.