


WELL PLUGGING RECORD

Give All Information Completely
Make Required Affidavit
Mail or Deliver Report to:
Conservation Division
State Corporation Commission
800 Bittling Building
Wichita, Kansas

Stafford County, Sec. 34 Twp. 21S Rge. 13 (W)

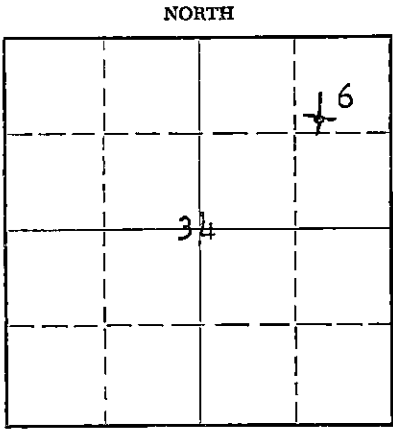

Locate well correctly on above Section Plat

Location as "NE/CNW/SW" or footage from lines SW NE NE
Lease Owner Magnolia Petroleum Company
Lease Name Mattie GATES Well No. 6
Office Address Box 900 Dallas, Texas
Character of Well (completed as Oil, Gas or Dry Hole) Dry
Date well completed 5-18-54 19
Application for plugging filed 8-6-54 19
Application for plugging approved 8-9-54 19
Plugging commenced 8-11-54 19
Plugging completed 8-14-54 19
Reason for abandonment of well or producing formation Dry Well
If a producing well is abandoned, date of last production None 19
Was permission obtained from the Conservation Division or its agents before plugging was commenced? YES

Name of Conservation Agent who supervised plugging of this well Merle Rives
Producing formation None Depth to top _____ Bottom _____ Total Depth of Well 3730 Feet
Show depth and thickness of all water, oil and gas formations.

OIL, GAS OR WATER RECORDS

CASING RECORD

FORMATION	CONTENT	FROM	TO	SIZE	PUT IN	PULLED OUT
None				9 5/8"	297'	None
				5 1/2"	3729'	2710'

Describe in detail the manner in which the well was plugged, indicating where the mud fluid was placed and the method or methods used in introducing it into the hole. If cement or other plugs were used, state the character of same and depth placed, from _____ feet to _____ feet for each plug set.

Plugged back w/crushed rock to 3655'; dumped 5 sx cmnt, bailed
and mudded hole back to 270'; set 5' rock bridge, mixed & put
in 20 sx cmnt, filled hole w/mud to 35'; set 5' rock bridge;
mixed and put in 10 sx cmnt to base of cellar.

RECEIVED
STATE CORPORATION COMMISSION
CONSERVATION DIVISION
Wichita, Kansas

9-13-54

(If additional description is necessary, use BACK of this sheet)
Name of Plugging Contractor Ace Pipe Pulling Company
Address Great Bend, Kansas

STATE OF Kansas, COUNTY OF Barton, ss.
C. A. Hill (employee of owner) or owner or operator of the above-described well, being first duly sworn on oath, says: That I have knowledge of the facts, statements, and matters herein contained and the log of the above-described well as filed and that the same are true and correct. So help me God.

(Signature) [Signature]
Box 770' Great Bend, Kansas
(Address)

SUBSCRIBED AND SWORN to before me this 10th day of September, 19 54

Harriett S. Kaiser
Notary Public.

My commission expires 1-14-57

PLUGGING
FILE SEC 34 T. 21 R. 13 W
BOOK PAGE 54 LINE 29

(7-53)
Magnolia Petroleum Company

X-2713-5-54

15.185.11635.0000

Dallas 21, Texas

8/17/54

Please furnish and ship promptly to *Magnolia Petroleum Company*

Producing Dept.
% C.A. Hill
Great Bend, Kansas

State Corporation Commission Conservation Div.
Wichita, Kansas

ADDRESS ALL COMMUNICATIONS
CONCERNING THIS ORDER TO
JOHN R. GUYNES,
PURCHASING AGENT.
P. O. BOX 900, DALLAS 21, TEXAS

Via: Delivered

Plugging Assessment of Well \$25.00

SW NE NE 34-21-13W
Stafford, Kansas
Stafford, County
File #54-29

Conf. Invoice Dated 8/16/54

RECEIVED
STATE CORPORATION COMMISSION
AUG 26 1954
CONSERVATION DIVISION
Wichita, Kansas

Charge: **Mattie Gates #6 (702)**
(Abandoned)

Plugging Well - NW

IMPORTANT: PLEASE NOTE THESE INSTRUCTIONS:

REQUISITION
REFERENCE

- (1) Order number must appear plainly on all packages and invoices, packing lists and shipping receipts.
- (2) Advise immediately if any shortage or delay in shipment.
- (3) To insure prompt payment of invoice, same must be issued in Duplicate on date of shipment.
- (4) Attach original bill of lading or express receipt to invoice.
- (5) Attach expense bill for prepaid freight or express.
- (6) Show cash discount on face of invoice, also whether freight was prepaid or collect.
- (7) Seller warrants free and clear title and freedom from defects. Seller further warrants that the goods or services, in the form delivered to or performed for Buyer, are free from any valid claim for patent infringement and that any labels or trade marks affixed thereto by or on behalf of Seller are free from any valid claim for copyright or trade mark infringement.
- (8) Seller warrants that goods sold or services furnished under this purchase order were produced or furnished in full and complete compliance with all applicable laws and regulations including, among others, the Fair Labor Standards Act as amended.
- (9) The acceptance of this order implies acceptance of the above conditions.

Seller, in accepting this order, hereby warrants that all amounts charged by Seller and payable pursuant hereto are lawfully chargeable under and shall not violate, directly or indirectly, the provisions of any present or future laws, decrees, regulations, rules or orders of any governmental authority which in any manner fix, limit, regulate, or otherwise affect prices at which said commodities may be sold.

Order No. KGW-4916

Magnolia Petroleum Company

JOHN R. GUYNES, Purchasing Agent

By _____ *P. J.*

MAGNOLIA PETROLEUM COMPANY

WELL RECORD

Mattie GATES #6
SW NE NE Sec. 34-21S-13W
Stafford County, Kansas

Gates Pool

Spudded: 4-25-54
Completed: 5-18-54
Plugged and abd. 5-20-54

Drilled By: Brack Drilling Co., Wichita, Kansas

9 5/8" set @ 297' w/225 sx cmnt circ. 4-25-54
5 1/2" set @ 3729' w/175 sx cmnt. 5-8-54

Top Soil & Clay	0	40
Sand	40	190
Shale & Shells	190	265
Red Bed	265	520
Red Bed & Shale	520	715
Anhydrite	715	745
Shale & Shells	745	1220
Red Bed	1220	1605
Lime & Shale	1605	1606
Lime	1606	1910
Lime & Shale	1910	2070
Shale & Lime	2070	2180
Lime & Shale	2180	2360
Shale & Lime	2360	2970
Lime & Shale	2970	3150
Lime	3150	3185
Lime & Shale	3185	3210
Shale & Lime	3210	3350
Lime & Shale	3350	3374
Lime	3374	3404
Lime & Shale	3404	3416
Lime	3416	3575
Chert & Lime	3575	3605
Lime	3605	3705
Arbuckle Lime	3705	3720
Lime	3720	3730
Total Depth	3730	
Total Depth	3730	
Plug Back Depth	3673	
Oil String Set @ (5 1/2")	3729	

RECEIVED
STATE CORPORA. COMMISSION
SEP 13 1954
CONSERVATION DIVISION
Wichita, Kansas

PLUGGING
FILE SEC. T R
BOOK PAGE LINE