

15-097-00039-0000

STATE OF KANSAS
STATE CORPORATION COMMISSION

Give All Information Completely
Make Required Affidavit
Mail or Deliver Report to:
Conservation Division
State Corporation Commission
800 Bitting Building
Wichita, Kansas

WELL PLUGGING RECORD

Kiowa County, Sec. 12 Twp 28 Rge. 16 (E) W (W)

Location as "NE/CNW/SW" or footage from lines SE SE SE

Lease Owner J. Walter Ross

Lease Name Peoples Bank Trust Well No. 1

Office Address 1910 North Lorraine, Wichita, Kansas

Character of Well (completed as Oil, Gas or Dry Hole) Dry Hole

Date well completed 1-4 19 56

Application for plugging filed 1-4 19 56

Application for plugging approved 1-4 19 56


Plugging commenced 1-4 19 56

Plugging completed 1-4 19 56

Reason for abandonment of well or producing formation Dry Hole

If a producing well is abandoned, date of last production 19

Was permission obtained from the Conservation Division or its agents before plugging was commenced? yes

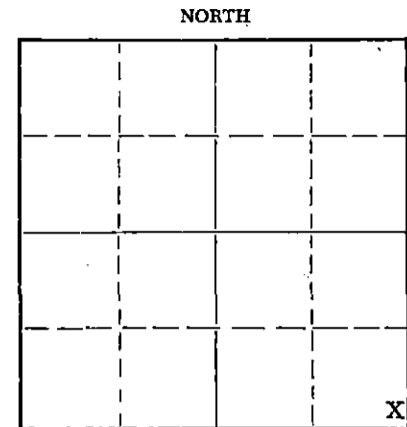

Locate well correctly on above Section Plat

Name of Conservation Agent who supervised plugging of this well M. A. Rives

Producing formation Depth to top Bottom Total Depth of Well 4996 Feet

Show depth and thickness of all water, oil and gas formations.

OIL, GAS OR WATER RECORDS

CASING RECORD

FORMATION	CONTENT	FROM	TO	SIZE	PUT IN	PULLED OUT
				8 5/8	355	0

Describe in detail the manner in which the well was plugged, indicating where the mud fluid was placed and the method or methods used in introducing it into the hole. If cement or other plugs were used, state the character of same and depth placed, from feet to feet for each plug set.

First plug set @ 350 feet with 20 sacks cement

Second plug set @ 35 feet with 10 sacks cement

1-7-56
RECEIVED
STATE CORPORATION COMMISSION
JAN 7 - 1956
CONSERVATION DIVISION
Wichita, Kansas

Name of Plugging Contractor Schafer Drilling Co. (If additional description is necessary, use BACK of this sheet)

Address Box 350, Pratt, Kansas

STATE OF Kansas, COUNTY OF Pratt, ss.

Lou Guthridge (employee of owner) or (owner or operator) of the above-described well, being first duly sworn on oath, says: That I have knowledge of the facts, statements, and matters herein contained and the log of the above-described well as filed and that the same are true and correct. So help me God.

(Signature) Lou Guthridge
Pratt, Mo. (Address)

SUBSCRIBED AND SWORN to before me this 4th day of January, 1956

My commission expires May 16, 1959 Notary Public.

PLUGGING
FILE SEC 12 Twp 28 R 16 W
BOOK PAGE 39 LINE 39

15-097-00039-0000

SCHAFFER DRILLING CO.

OFFICE OF THE PRESIDENT

PEOPLES BANK BUILDING

PRATT, KANSAS

WILLIAM SCHAFFER
PRESIDENT

PHONE
042

DRILLERS LOG
PEOPLES BANK TRUST #1
KIOWA COUNTY, KANSAS

0-290	Sand and Red Bed
290-370	Shale and Red Bed
370-395	Anhydrite
395-1040	Shale and Shell
1040-1080	Anhydrite
1080-2125	Shale and Shells
2125-2540	Lime and Shale
2540-2620	Shale and Shells
2620-3600	Lime and Shale
3600-3690	Lime
3690-4370	Lime and Shale
4370-4520	Lime
4520-4585	Lime and Shale
4585-4635	Lime, Shale and Sand
4635-4657	Lime, Shale and Chert
4657-4675	Lime and Chert
4675-4705	Lime, Shale and Chert
4705-4725	Lime and Chert
4725-4935	Lime, Shale and Chert
4935-4996	Shale and Lime
4996	TOTAL DEPTH

RECEIVED
STATE CORPORATE COMMISSION
JAN 7 - 1956
CONSERVATION DIVISION
Wichita, Kansas

I certify that the above drillers log is true and correct as taken directly from the daily drilling reports of the Peoples Bank Trust #1.

Law Jean Guthridge
Schaffer Drilling Co.

State of Kansas: County of Pratt: SS

The above was subscribed and sworn to before me this 4th day of January, 1956.

Marilyn Guthridge
Notary Public

My commission expires May 16, 1959

—ROTARY DRILLING CONTRACTOR—

PLUGGING
FILE NO. P2 T 28 R 6W
BLOCK PAGE 21 LINE 39