


STATE OF KANSAS
STATE CORPORATION COMMISSION

Form CP-4

WELL PLUGGING RECORD

Give All Information Completely
Make Required Affidavit
Mail or Deliver Report to:
Conservation Division
State Corporation Commission
P. O. Box 17027
Wichita, Kansas 67217
NORTH

Kiowa County, Sec. 12 Twp. 28 Rge. 16 (E) (W)
Location as "NE/CNW/SW" or footage from lines SE SE SE
Lease Owner Rains & Williamson Oil Co.
Lease Name ~~XXX~~ Peoples Bank #1 Well No.
Office Address Wichita, Kansas 67202
Character of Well (completed as Oil, Gas or Dry Hole)
Date well completed 19
Application for plugging filed 19
Application for plugging approved 19
Plugging commenced 10/31/73 19
Plugging completed 11/2/73 19
Reason for abandonment of well or producing formation depleted

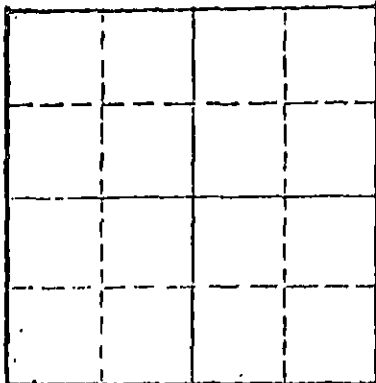

Locate well correctly on above Section Plat

If a producing well is abandoned, date of last production 19
Was permission obtained from the Conservation Division or its agents before plugging was commenced? Yes

Name of Conservation Agent who supervised plugging of this well Biberstein
Producing formation Depth to top Bottom Total Depth of Well 3602 Feet
Show depth and thickness of all water, oil and gas formations.

OIL, GAS OR WATER RECORDS

CASING RECORD

FORMATION	CONTENT	FROM	TO	SIZE	PUT IN	PULLED OUT
				8-5/8	390	none
				4 1/2	3565	2962'

Describe in detail the manner in which the well was plugged, indicating where the mud fluid was placed and the method or methods used in introducing it into the hole. If cement or other plugs were used, state the character of same and depth placed, from feet to feet for each plug set.

Checked bottom, ran sand to 3550' and ran 3 sacks cement.
Shot pipe at 3015', worked loose and pulled 91 joints. Bailed hole to 260', set 10' rock bridge and dumped 4 yards ready mix.

PLUGGING COMPLETE.

RECEIVED
STATE CORPORATION COMMISSION
DEC 10 1973
CONSERVATION DIVISION
Wichita, Kansas

(If additional description is necessary, use BACK of this sheet)
Name of Plugging Contractor KNIGHT CASING PULLING CO., INC.
Address CHASE, KANSAS

STATE OF KANSAS COUNTY OF RICE
NOEL J. KNIGHT (employee of owner) or (owner or operator) of the above-described

well, being first duly sworn on oath, says: That I have knowledge of the facts, statements, and matters herein contained and the log of the above-described well as filed and that the same are true and correct. So help me God.

(Signature) Noel Knight
CHASE, KANSAS
(Address)

Subscribed and Sworn to before me this 29th day of November, 1973

Margaret Melcher
Notary Public.

My commission expires
MARGARET MELCHER
NOTARY PUBLIC
Rice County, Kansas
My Commission Expires
Feb. 15, 1975

15-097-00039-00-01

RECEIVED
STATE CORPORATION COMMISSION

DRILLER'S LOG

SEP 10 1973

CONSERVATION DIVISION

COMPANY:

RAINS & WILLIAMSON OIL CO., INC.
435 Page Court, 220 W. Douglas
Wichita, Kansas 67202

WELL NAME:

PEOPLES BANK # 1 (OWWO)
SE SE SE Section 12-28S-16W
Kiowa County, Kansas

CONTRACTOR:

RAINS & WILLIAMSON OIL CO., INC.
435 Page Court, 220 W. Douglas
Wichita, Kansas 67202

WASHDOWN COMMENCED:

AUGUST 13, 1973

WASHDOWN COMPLETED:

AUGUST 18, 1973

CASING RECORD:

4 1/2" @ 3565' w/ 100 sacks common, 18% salt,
2% gel, 3/4 of 1% CFR2 & 12# gilsonite.

FORMER OWNER:

SCHAFFER DRILLING CO.

FORMER NAME:

BANK #1

FORMERLY COMPLETED:

1956

The old hole was re-entered and washed down as follows:

0 - 390	Cement
3602	Washdown
<u>3602</u>	<u>Total Depth</u>

The undersigned, Wilson Rains, hereby certifies, in behalf of said company that the above log is a true and correct log in washing down the above well as reflected by the Daily Drilling Reports.

RAINS & WILLIAMSON OIL CO., INC.

By Wilson Rains
Wilson Rains, President

STATE OF KANSAS)
) ss:
COUNTY OF SEDGWICK)

Be it remembered that on this 6th day of September, 1973, before me, the undersigned, a Notary Public, duly commissioned, in and for the county and state aforesaid, came WILSON RAINS, President of RAINS & WILLIAMSON OIL CO., INC., a corporation of the State of Kansas, personally known to me to be such officer, and to be the same person who executed as such officer the foregoing instrument of writing in behalf of said corporation, and he duly acknowledged the execution of the same for himself and for said corporation.

IN WITNESS WHEREOF, I have hereunto set my hand and official seal on the _____ day and _____ year last above written.

My Commission Expires:
October 4, 1975

Juanita M. Green
Juanita M. Green - Notary Public

