


15-097-20855-00-00

WELL PLUGGING RECORD

Give All Information Completely  
 Make Required Affidavit

COUNTY Kiowa SEC. 12 TWP. 28S RGE. 16W E/W  
 Location as in quarters or footage from lines:  
SW/4 NW/4 NE/4

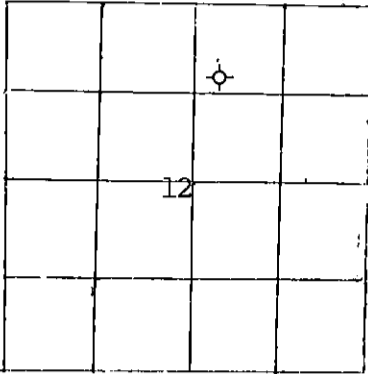

Locate Well  
 correctly on above  
 Section Platt.

Lease Owner Gear Petroleum Company, Inc.  
 Lease Name Wellsford Kinney Trust "B" Well No. 1-12  
 Office Address 300 Sutton Place, Wichita, Kansas 67202  
 Character of Well (Completed as Oil, Gas or Dry Hole): D & A  
 Date Well Completed March 4, 1982  
 Application for plugging filed March 4, 1982  
 Plugging commenced March 4, 1982  
 Plugging completed March 4, 1982  
 Reason for abandonment of well or producing formation D & A

Was permission obtained from the Conservation Division or it's  
 Agent's before plugging was commenced? Yes

Name of Conservation Agent who supervised plugging of this well Paul Luthi

Producing formation \_\_\_\_\_ Depth to top \_\_\_\_\_ bottom \_\_\_\_\_ T.D. 4,824'

Show depth and thickness of all water, oil and gas formations.

OIL, GAS OR WATER RECORDS Casing Record

Formation	Content	From	To	Size	Put in	Pulled Out
				8 5/8"	406.29'	-0-

Describe in detail the manner in which the well was plugged, indicating where the mud  
 fluid was placed and the method or methods used in introducing it into the hold. If cement  
 or other plugs were used, state the character of same and depth placed, from \_\_\_\_\_ feet  
 to \_\_\_\_\_ feet for each plug set.

Plugged hole  
 1st Plug @ 1054' w/60 sx cement  
 2nd Plug, push Rubber Plug to 380' then 40 sx cement  
 3rd Plug @ 40' w/Solid Bridge & 10 sx cement  
 15 sx cement in Rathole  
 Common cement, 4% Gel

(If additional description is necessary, use BACK of this sheet)

Name of Plugging Contractor Red Tiger Drilling Company  
1720 KSB Building, Wichita, Kansas 67202

STATE OF Kansas COUNTY OF Sedgwick, ss.  
Jim Thatcher, Prod. Mgr., Gear Pet. Co. (employee of owner) or (owner or operator) of the  
 above-described well, first duly sworn on oath, says: That I have knowledge of the  
 facts, statements, and matters herein contained and the log of the above-described well as  
 filed and that the same are true and correct. So help me God.

RECEIVED  
 MAR 26 10 00 AM  
 CONSERVATION DIVISION  
 Wichita Kansas

3-20-82

(Signature) Jim Thatcher  
300 SUTTON PLACE  
WICHITA, KS 67202  
 (Address)

SUBSCRIBED AND SWORN TO before me this 24th day of March, 19 82

Jenna Sarver  
 Notary Public.

My Commission expires: 2-18-84

