


15.145.20833.0000

WELL PLUGGING RECORD

Give All Information Completely
 Make Required Affidavit

COUNTY Pawnee SEC. 8 TWP. 21 RGE. 18 E/W
 Location as in quarters or footage from lines:

C NW

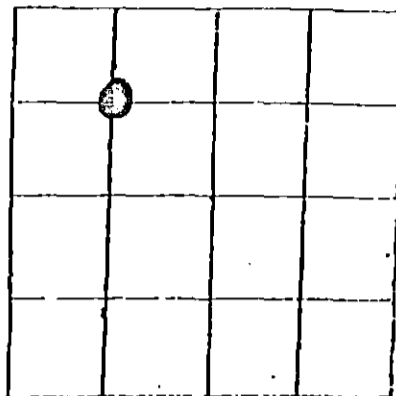

Locate Well
 correctly on above
 Section Platt.

Lease Owner Anador Resources, Inc.
 Lease Name Bryant Well No. 1-8
 Office Address 5700 S. Quebec, Suite 320, Englewood, CO 80111
 Character of Well (Completed as Oil, Gas or Dry Hole):
 Date Well Completed June 30, 1982
 Application for plugging filed June 30, 1982
 Plugging commenced August 13, 1982
 Plugging completed August 13, 1982
 Reason for abandonment of well or producing formation

DRY

Was permission obtained from the Conservation Division or it's
 Agent's before plugging was commenced? Yes

Name of Conservation Agent who supervised plugging of this well Steve Durrant

Producing formation NONE Depth to top _____ bottom T.D. 2305

Show depth and thickness of all water, oil and gas formations.

OIL, GAS OR WATER RECORDS

Casing Record

Formation	Content	From	To	Size	Put in	Pulled Out
Krider	water	2121	2146	7"	988	NONE
Winfield	water	2174	2200			

Describe in detail the manner in which the well was plugged, indicating where the mud
 fluid was placed and the method or methods used in introducing it into the hold. If cement
 or other plugs were used, state the character of same and depth placed, from _____ feet
 to _____ feet for each plug set.

Hooked up on 7" casing and pumped as follows:

RECEIVED
 STATE CORPORATION COMMISSION
 SEP 16 1982
 CONSERVATION DIVISION
 Wichita, Kansas

2 SXS. HULLS

5 SXS. GEL

1 7" PLUG

160 SXS. 50-50 POZ w/3%cc & 4% GEL

Shut In with 300 PSIG

(If additional description is necessary, use BACK of this sheet)

Name of Plugging Contractor Sun Cementers

STATE OF Colorado COUNTY OF Arapahoe, ss.

David S. Dudzik (employee of owner) or (owner or operator) of the
 above-described well, being first duly sworn on oath, says: That I have knowledge of the
 facts, statements, and matters herein contained and the log of the above-described well as
 filed and that the same are true and correct. So help me God.

(Signature) David S. Dudzik

David S. Dudzik
 5700 S. Quebec (Address)

SUBSCRIBED AND SWORN TO before me this 8th day of September, 1982

Constance A. Lowe
 Constance A. Lowe Notary Public.

My Commission expires: 01/25/84