

15.145.20557.0000

STATE OF KANSAS
STATE CORPORATION COMMISSION

WELL PLUGGING RECORD

Give All Information Completely
Make Required Affidavit
Mail or Deliver Report to
Conservation Division
State Corporation Comm.
245 North Water
Wichita, KS 67202

Pawnee County, Sec. 12 Twp. 21 Rge. 17 E/W
Location as "NE/CNW 1/4 SW 1/4" or footage from lines
C NE/4 SW/4

Lease Owner Mahoney Drilling Co., Inc.
Lease Name Hewson Well No. 1

Office Address 320 So. Boston Suite 805 Tulsa, Okla. 74103
Character of Well (Completed as Oil, Gas or Dry Hole)

Dry Hole


Date Well completed 12-10 1978
Application for plugging filed 12-10 1978
Application for plugging approved 12-10 1978
Plugging commenced 12-10 1978
Plugging completed 12-10 1978

Reason for abandonment of well or producing formation
Dry Hole

If a producing well is abandoned, date of last production
N A 19

Was permission obtained from the Conservation Division or
its agents before plugging was commenced? Yes

Name of Conservation Agent who supervised plugging of this well Leo Massey
Producing formation N A Depth to top Bottom Total Depth of Well
Show depth and thickness of all water, oil and gas formations.

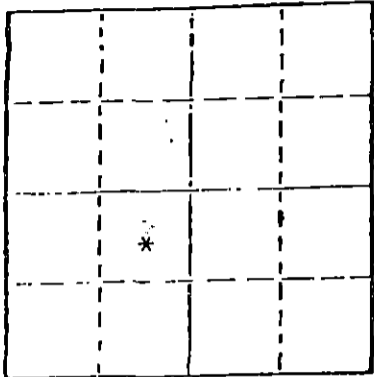

Locate well correctly on above
Section Plat

OIL, GAS OR WATER RECORDS

CASING RECORD

FORMATION	CONTENT	FROM	TO	SIZE	PUT IN	PULLED OUT
Artesian Sandstone	Salt Water	450'	585'	8-5/8	1006'	0

Describe in detail the manner in which the well was plugged, indicating where the mud fluid was placed and the method or methods used in introducing it into the hold. If cement or other plugs were used, state the character of same and depth placed, from _____ feet to _____ feet for each plug set.

- 40 Sacks 50/50 poz + 2% CC @ 420'
- 10 Sacks 50/50 poz + 2% CC 40' Solid bridge to surface.
- 3 Sacks 50/50 poz + 2% CC in rathole
- 2 Sacks 50/50 poz + 2% CC in Water well

RECEIVED
STATE CORPORATION COMMISSION

JAN 23 1979

CONSERVATION DIVISION
Wichita, Kansas

(If additional description is necessary, use BACK of this sheet)

Name of Plugging Contractor Haliburton

STATE OF Kansas COUNTY OF Pratt, ss.
William K. Black (employee of owner) or (owner or operator)
of the above-described well, being first duly sworn on oath, says: That I have knowledge of the facts, statements, and matters herein contained and the log of the above-described well as filed and that the same are true and correct. So help me God.

(Signature) William K. Black
P.O. Box 510 Pratt, Ks. 67124
(Address)

SUBSCRIBED AND SWORN TO before me this 22nd day of January, 1979

PHYLLIS GOSS
State Notary Public
Pratt County, Kansas
Appointment Expires: 3-23-80

Phyllis Goss
Notary Public.

My commission expires _____

GABBERT-JONES, INC.
WICHITA, KANSAS
DRILLERS' WELL LOG

Hewson #1
C-NE-SW Sec 12-21S-17W
Pawnee County Kansas

Commenced: 12-2-78

Completed: 12-10-78

OPERATOR: Mahoney Drilling Co., Inc.

Depth		Formation	Remarks
From	To		
0	260	Surface Clay-Sand-Shale	Ran 19 jts of 230 8 5/8" csg
260	760	Shale-Sand-Redbed	766.02 on Bottom - Ran
760	935	Shale-Redbed	6 jts of New 20# 8 5/8" on Top
935	998	Shale	set @ 1004' w/Texas
998	1046	Anhy	Pattern Shoe & Insert Float
1046	1335	Shale-Shells	@ 971' Cantrilizer 1st
1335	2015	Shale	15th & 24th jts Cemented
2015	2760	Lime-Shale	w/300 sks Halcolite
2760	2945	Shale-Lime	150 sks Common 3% CC
2945	3440	Lime-Shale	PD @ 9:00 p.m. 12-3-78
3440	3900	Lime	
	3900 - TD		DRY & ABANDONED

STATE OF KANSAS)
) SS
COUNTY OF SEDGWICK)

I, the undersigned, being duly sworn on oath, state that the above Drillers' Well Log is true and correct to the best of my knowledge and belief and according to the records of this office.

GABBERT-JONES, INC.

James S. Sutton II
JAMES S. SUTTON II

Subscribed and sworn to before me this 15th day of December, 1978.

Elizabeth J. Edwards
ELIZABETH J. EDWARDS-NOTARY PUBLIC

My Commission expires February 6, 1979.

